

Tate Co

G37

MISSISSIPPI
 BOARD OF WATER COMMISSIONERS
 416 North State Street
 Jackson, Mississippi 39201

#2

WATER WELL DRILLERS LOG

2/22

1972 LIPE WELL & SUPPLY CO.

TATE

date well completed

firm name

county well located

LANDOWNER:

CITY OF SENATOBIA

SENATOBIA, MISS

(mailing address)

WELL LOCATION:

sec 20 T 5 N R 7 E
 Chromcraft
 miles of (nearest town)

WELL PURPOSE: MUNICIPAL TEST
 (home, irrigation, municipal, industrial)

WELL COMPLETION DATA:

- (1) diameter (inches) 8"
- (2) total depth (feet) 1200
- (3) static water level (feet) 65 below top of ground.
- (4) casing Steel, 1160
(material) (depth)
- 4" If telescope see back.
(size)
- (5) screen 20", 1160
(length) (depth to top)
- 1/2", S.S.
(size) (material)
- (6) pump 5, 60
(HP) (yield gpm)
- elec.
(type power)
- (7) electric log yes
(yes or no)
- MS
(organization running log)
- (8) how well bottom plugged steel

description of formations encountered

from

to

sandy gumbo	820	840
shale	840	860
shale	860	880
sandy shale	880	900
shale	900	920
shale	920	940
shale	940	960
shale	960	980
shale	980	1000
shale	1000	1020
sandy shale	1020	1040
shale	1040	1060
shale	1060	1080
sandy shale	1080	1100
sandy shale	1100	1120
sand	1120	1140
sandy	1140	1160
sand	1160	1180
shale	1180	1200
shale	1200	1220


DRILLERS REMARKS:

MISS. BD. OF
 WATER COMMISSIONERS

JUL 17 1972

If well telescopes please sketch and show depths.

GROUND LEVEL

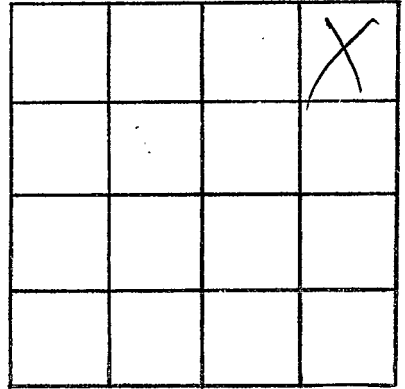

SECTION 20

Please indicate well location X.

ADDITIONAL INFORMATION

If more than one screen,
show locations of each on sketch.