

TATE
G39
3-16-72

CODED

MISSISSIPPI
BOARD OF WATER COMMISSIONERS
416 North State Street
Jackson, Mississippi 39201

MAR 22 1972

WATER WELL DRILLERS LOG


3/16/1972 G. and H. Well Company Tate
date well completed firm name county well located

LANDOWNER:	description of formations encountered	from	to
Robert Daniel Route 2 Coldwater, Mississippi (mailing address)			
WELL LOCATION: sec. 8 T5 N R. 7 E 4 miles SE of Coldwater (distance) (direction) (nearest town)	Gravel	15	30
	Gravel & Clay	30	45
	White Clay	45	75
	White Clay & Sand	75	105
	White Clay & Sand	105	120
WELL PURPOSE: Home (home, irrigation, municipal, industrial)	White Sand	120	165
WELL COMPLETION DATA:			
(1) diameter (inches) 4 In			
(2) total depth (feet) 165			
(3) static water level (feet) 75 below above top of ground.			
(4) casing Plastic, 165 (material) (depth)			
(size) If telescope see back.			
(5) screen 10 FT, 165 (length) (depth to top)			
4 In, Gravel (size) (material)			
(6) pump 3/4 10 GPM (HP) (yield gpm)			
Electric 220 (type power)			
(7) electric log no (yes or no)			
(organization running log)			
(8) how well bottom plugged cap			
DRILLERS REMARKS:			

CODED

If well telescopes please sketch and show depths.

GROUND LEVEL

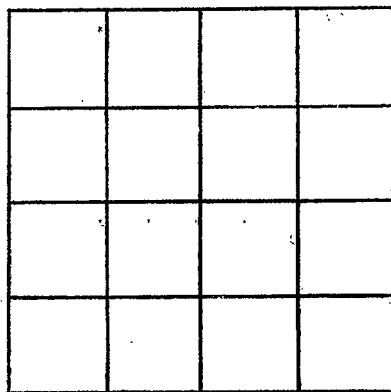

SECTION _____

Please indicate well location X.

ADDITIONAL INFORMATION

If more than one screen,
show locations of each on sketch.