

TATE
G 41
3-1-72

MISSISSIPPI
BOARD OF WATER COMMISSIONERS
416 North State Street
Jackson, Mississippi 39201

CODED

WATER WELL DRILLERS LOG

3-1-72 date well completed 1972 Harris Bros. firm name Tate county well located

LANDOWNER	description of formations encountered	from	to
Larry Mathis Rt. 1	top soil	0	15
Senatobia (mailing address)	pea gravel	15	40
WELL LOCATION: sec 27 T-S R-7 E 3 miles E of Senatobia	fine sand	40	85
(distance) (direction) (nearest town)	coarse sand	85	100
WELL PURPOSE: home (home, irrigation, municipal, industrial)			
WELL COMPLETION DATA:			
(1) diameter (inches) 4			
(2) total depth (feet) 100			
(3) static water level (feet) 60 below top of ground.			
(4) casing Plaster, 93 (material) (depth)			
4 (size) if telescope see back.			
(5) screen 7' 93 (length) (depth to top)			
008 Plaster (size) (material)			
(6) pump 3/4 10 (HP) (yield gpm)			
elec. (type power)			
(7) electric log no (yes or no)			
(organization running log)			
(8) how well bottom plugged solid			
DRILLERS REMARKS:			


CODED

AUG 7 1972

MISS. BD. OF
WATER COMMISSIONERS

If well telescopes please sketch and show depths.

GROUND LEVEL

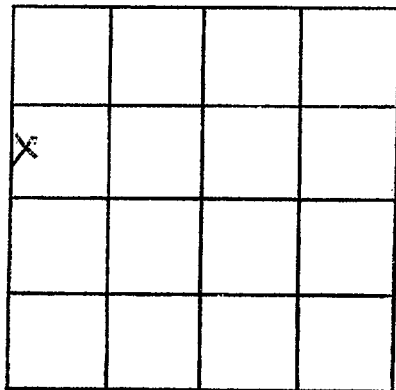

SECTION 27

Please indicate well location X.

ADDITIONAL INFORMATION

If more than one screen,
show locations of each on sketch.