

TATE
G 45
5-5-72

MISSISSIPPI
BOARD OF WATER COMMISSIONERS
416 North State Street
Jackson, Mississippi 39201

WATER WELL DRILLERS LOG

CODED

5-5
date well completed

1972

Harris Bros. Lute
firm name

county well located

LANDOWNER: ~~SS~~

W.E. Childress
Rt. 1 Senatobia
(mailing address)

description of formations
encountered

from

to

top soil

0

20

sand & gravel

20

45

clay + sand

45

125

Coarse sand

125

140

WELL LOCATION:

sec. 35 T 5 N R 7 E
1/2 miles S of New Town
(distance) (direction) (nearest town)

WELL PURPOSE: home
(home, irrigation, municipal, industrial)

WELL COMPLETION DATA:

- (1) diameter (inches) 4
- (2) total depth (feet) 140
- (3) static water level (feet) 80 ^{below} _{above} top of ground.
- (4) casing Plastic, 13-3,
(material) (depth)
4
(size) If telescope see back.
- (5) screen 7', 133'
(length) (depth to top)
008, Plastic
(size) (material)
- (6) pump 3/4 10
(HP) (yield gpm)
elec.
(type power)
- (7) electric log no
(yes or no)

(organization running log)
- (8) how well bottom plugged solid

CODED


DRILLERS REMARKS:

OCT 18 1972

MISS. RD. OF
WATER COMM.

If well telescopes please sketch and show depths.

GROUND LEVEL

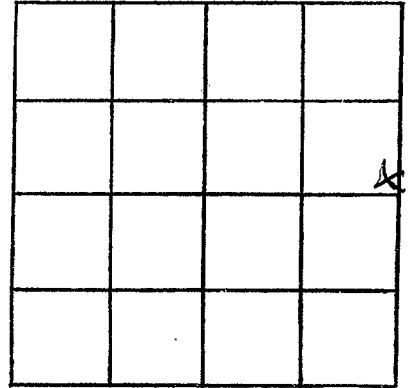

SECTION 25

Please indicate well location X.

ADDITIONAL INFORMATION

If more than one screen, show locations of each on sketch.