

MISSISSIPPI
BOARD OF WATER COMMISSIONERS
416 North State Street
Jackson, Mississippi 39201

CODED

WATER WELL DRILLERS LOG

TATE
G 46
8-1-72

8-1
date well completed

1972 Barnes Bros
firm name

Tate
county well located

LANDOWNER: Jerry Mathis
Senatobia
(mailing address)
WELL LOCATION:
sec. 27 T 5 N R. 7 E
2 miles NE of Senatobia
(distance) (direction) (nearest town)

description of formations encountered	from	to
<u>top soil</u>	<u>0</u>	<u>15</u>
<u>red sand</u>	<u>15</u>	<u>50</u>
<u>clay & sand</u>	<u>50</u>	<u>90</u>
<u>Coarse sand</u>	<u>90</u>	<u>180</u>

WELL PURPOSE: hailer Park
(home, irrigation, municipal, industrial)

WELL COMPLETION DATA:
(1) diameter (inches) 4
(2) total depth (feet) 130
(3) static water level (feet) 60 below top of ground.
(4) casing Plastic, 102
(material) (depth)
4 if telescope see back.
(size)
(5) screen 28, 102
(length) (depth to top)
008, Plastic
(size) (material)
(6) pump 5, 100
(HP) (yield gpm)
dec.
(type power)
(7) electric log no
(yes or no)
(organization running log)
(8) how well bottom plugged solid

CODED


NOV - 1 1972

DRILLERS REMARKS:

NOV 05 1972

If well telescopes please sketch and show depths.

GROUND LEVEL

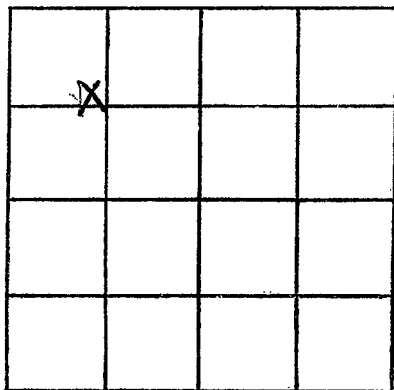

SECTION 27

Please indicate well location X.

ADDITIONAL INFORMATION

If more than one screen,
show locations of each on sketch.