

TATE
G 51
1-4-73

MISSISSIPPI
BOARD OF WATER COMMISSIONERS
416 North State Street
Jackson, Mississippi 39201

CODED

WATER WELL DRILLERS LOG

1-4 1973 James B. Lipe Tate
date well completed firm name county well located

LANDOWNER: Jerry Harrison

Senatobia
Miss.
(mailing address)

WELL LOCATION:
sec. 10 T 5 N R 7 E
5 miles N.E. of Senatobia
(distance) (direction) (nearest town)

WELL PURPOSE: Home
(home, irrigation, municipal, industrial)

WELL COMPLETION DATA:

- (1) diameter (inches) 4"
- (2) total depth (feet) 160
- (3) static water level (feet) 100 below top of ground.
- (4) casing PVC, 150 (material), (depth)
4 (size) if telescope see back.
- (5) screen 10, 150 (length), (depth to top)
4, PVC (size), (material)
- (6) pump 3/4, 10 (HP), (yield gpm)
Elec. (type power)
- (7) electric log no (yes or no)
no (organization running log)
- (8) how well bottom plugged PVC Plug

description of formations encountered	from	to
TOP SOIL	0	20
CLAY	20	40
SAND	40	60
CLAY	60	80
CLAY	80	100
SAND	100	120
SAND	120	160

CODED


FEB 6 1981

DRILLERS REMARKS:

MSD
WAL

If well telescopes please sketch and show depths.

GROUND LEVEL

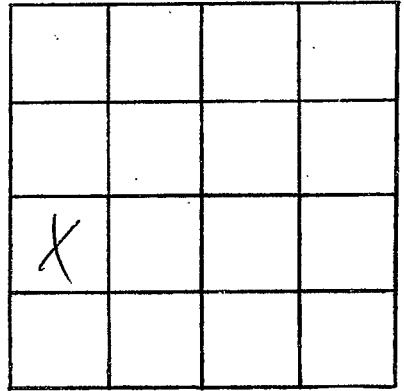

SECTION 10

Please indicate well location X.

ADDITIONAL INFORMATION

If more than one screen,
show locations of each on sketch.