

TATE  
G53  
9-25-72

MISSISSIPPI BOARD OF WATER COMMISSIONERS  
416 North State Street  
Jackson, Mississippi 39201

CODED

WATER WELL DRILLERS LOG

9-25-1972 Bob Smith Tate  
date well completed firm name county well located


LANDOWNER:	description of formations encountered	from	to
Ruber Wright			
Coldwater, Miss. (mailing address)	Red sand	2	6
WELL LOCATION:	gravel	6	30
sec. 6 T 5 N R 7 E (S) (W)	white sand	30	136
4 1/2 miles SE of Coldwater (distance) (direction) (nearest town)			
WELL PURPOSE: Home (home, irrigation, municipal, industrial)			
WELL COMPLETION DATA:			
(1) diameter (inches) 4			
(2) total depth (feet) 136			
(3) static water level (feet) 100 below top of ground.			
(4) casing Plastic 136 (material) (depth)			
(size) If telescope see back.			
(5) screen 30 116 (length) (depth to top)			
(size) 4 Plastic (material)			
(6) pump 1/3 10 (HP) (yield gpm)			
(type power) E lec.			
(7) electric log no (yes or no)			
(organization running log)			
(8) how well bottom plugged plugged			
DRILLERS REMARKS:			

CODED

FEB 22 1973

If well telescopes please sketch and show depths.

GROUND LEVEL

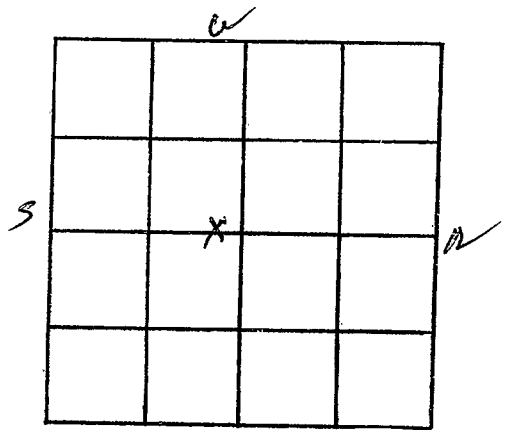

SECTION 6

Please indicate well location X.

ADDITIONAL INFORMATION

If more than one screen, show locations of each on sketch.