

TATE
G 55
6-19-72

MISSISSIPPI
BOARD OF WATER COMMISSIONERS
416 North State Street
Jackson, Mississippi 39201

CODED

WATER WELL DRILLERS LOG


6-19-1972 Bob Hill Tate
date well completed firm name county well located

LANDOWNER:	description of formations encountered	from	to
Curtis Avert	clay lint		16
Senatobia, miss. (mailing address)	Red sand + gravel	16	45
WELL LOCATION:	Red clay	45	55
sec. 35 T 5 N R 7 E S W	Blue clay	55	96
1 1/4 miles SE of New Town (distance) (direction) (nearest town)	white sand	96	145
WELL PURPOSE: Home (home, irrigation, municipal, industrial)			
WELL COMPLETION DATA:			
(1) diameter (inches) 4			
(2) total depth (feet) 145			
(3) static water level (feet) 12 below top of ground.			
(4) casing P. lath (material), 145 (depth)			
4 (size) if telescope see back.			
(5) screen 20 (length), 135 (depth to top)			
4 (size), P. lath (material)			
(6) pump 1/2 (HP), 10 (yield gpm)			
Elec. (type power)			
(7) electric log no (yes or no)			
(organization running log)			
(8) how well bottom plugged plugged			
DRILLERS REMARKS:			

CODED

If well telescopes please sketch and show depths.

GROUND LEVEL

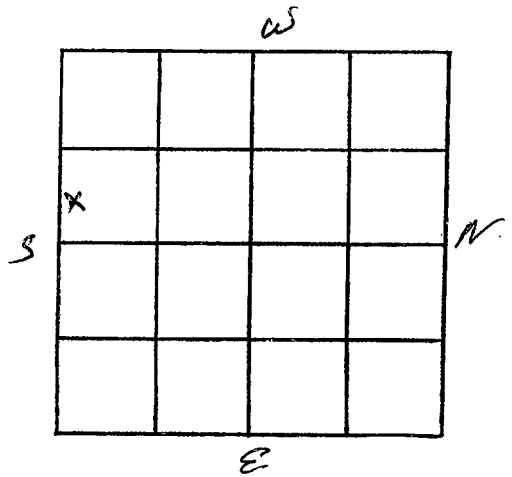

SECTION 35

Please indicate well location X.

ADDITIONAL INFORMATION

If more than one screen,
show locations of each on sketch.