

MISSISSIPPI
BOARD OF WATER COMMISSIONERS
416 North State Street
Jackson, Mississippi 39201

CODED

WATER WELL DRILLERS LOG

TATE
G57
9-30-72

9-30

1972 Harris Bros.

Zato

date well completed

firm name

county well located

LANDOWNER:

Henry Billingsly

description of formations encountered

from

to

RT1

Senatoria

(mailing address)

top soil

0

15

red sand

15

50

clay sand

50

125

Coarse sand

125

140

WELL LOCATION:

sec. 2 T 5 N R 7 E

1/2 miles W of New Town

WELL PURPOSE:

(home, irrigation, municipal, industrial)

home

WELL COMPLETION DATA:

(1) diameter (inches)

4

(2) total depth (feet)

140

(3) static water level (feet)

80

below above

top of ground.

(4) casing

Plastic

133'

(material)

(depth)

4'

(size)

if telescope see back.

(5) screen

7'

(length)

133'

(depth to top)

008

(size)

Plastic

(material)

(6) pump

3/4

(HP)

7

(yield gpm)

elec

(type power)

(7) electric log

no

(yes or no)

(organization running log)

(8) how well bottom plugged

solid


DRILLERS REMARKS:

CODED

MS 98 1173

If well telescopes please sketch and show depths.

GROUND LEVEL

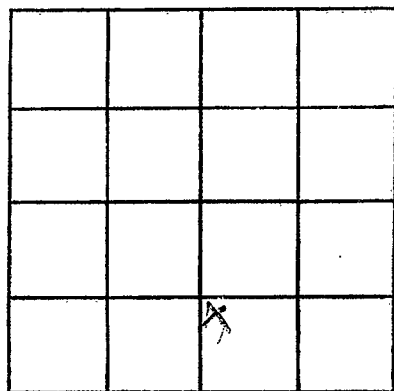

SECTION 2

Please indicate well location X.

ADDITIONAL INFORMATION

If more than one screen,
show locations of each on sketch.