

MISSISSIPPI
BOARD OF WATER COMMISSIONERS
416 North State Street
Jackson, Mississippi 39201

CODED

WATER WELL DRILLERS LOG

TATE
G58
7-15-72

7-15 1972 date well completed
Harris Bros. firm name
Tate county well located


LANDOWNER: <u>Jack Cutter</u> <u>Rt. 1</u> <u>Senatobia</u> (mailing address)	description of formations encountered	from	to
	<u>top soil</u>	<u>0</u>	<u>15</u>
	<u>red sand</u>	<u>15</u>	<u>45</u>
WELL LOCATION: sec. <u>13</u> T. <u>5</u> N. R. <u>7</u> E <u>2 1/2</u> miles <u>NE</u> of <u>New Town</u> (distance) (direction) (nearest town)	<u>clay + sand</u>	<u>45</u>	<u>85</u>
	<u>Coarse sand</u>	<u>85</u>	<u>100</u>
WELL PURPOSE: <u>none</u> (home, irrigation, municipal, industrial)			
WELL COMPLETION DATA: (1) diameter (inches) <u>4</u> (2) total depth (feet) <u>100</u> (3) static water level (feet) <u>60</u> <u>below</u> above top of ground. (4) casing <u>Plaster</u> , <u>93'</u> (material) (depth) <u>4</u> if telescope see back. (size) (5) screen <u>7</u> , <u>93'</u> (length) (depth to top) <u>008</u> , <u>Plaster</u> (size) (material) (6) pump <u>3/4</u> , <u>10</u> (HP) (yield gpm) <u>etc.</u> (type power) (7) electric log <u>no</u> (yes or no) (organization running log) (8) how well bottom plugged <u>solid</u>			
DRILLERS REMARKS:			

CODED

MAR 25 1973

If well telescopes please sketch and show depths.

GROUND LEVEL

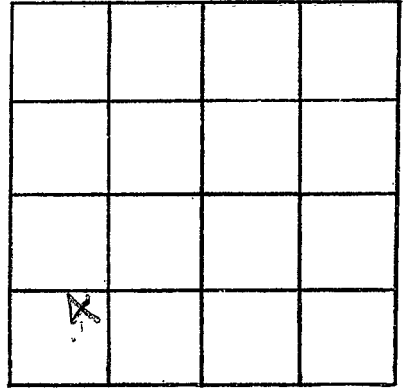

SECTION B

Please indicate well location X.

ADDITIONAL INFORMATION

If more than one screen,
show locations of each on sketch.