

TATE
 G 60
 4-2-73

MISSISSIPPI
 BOARD OF WATER COMMISSIONERS
 416 North State Street
 Jackson, Mississippi 39201
 WATER WELL DRILLERS LOG

CODED

4-2-1973 date well completed
 Hicks Bros, well co. firm name
 Tate county well located

LANDOWNER	description of formations encountered	from	to
George Little			
Route 1			
Senatobia, Miss	Red Clay + Shovel	0	15
(mailing address)	Shovel	15	25
	White Sand	25	30

WELL LOCATION:
 sec 26 T 5 N R 7 E
 S W
 9 miles SE of Senatobia
 (distance) (direction) (nearest town)

WELL PURPOSE: Home
 (home, irrigation, municipal, industrial)


- WELL COMPLETION DATA:
- (1) diameter (inches) 4 in
 - (2) total depth (feet) 130
 - (3) static water level (feet) 12 below top of ground
 - (4) casing (material) Plastic (depth) 130
 (size) if telescope see back.
 - (5) screen 4 ft, 126
 (length) (depth to top)
 4 in Shovel
 (size) (material)
 - (6) pump 3/4 10
 (HP) (yield gpm)
 Electric 220
 (type power)
 - (7) electric log no
 (yes or no)
 - (8) how well bottom plugged Cap
 (organization running log)

CODED

DRILLERS REMARKS:
 APR 10 1973

If well telescopes please sketch and show depths.

GROUND LEVEL

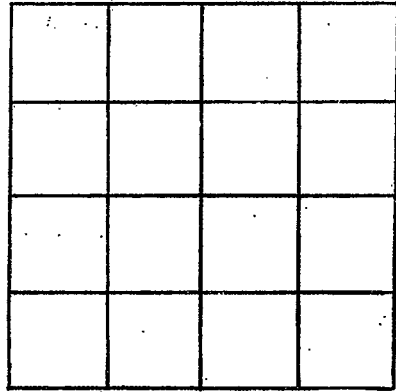

SECTION _____

Please indicate well location X.

ADDITIONAL INFORMATION

If more than one screen, show locations of each on sketch.