

TATE
 G 63
 6-29-73

MISSISSIPPI
 BOARD OF WATER COMMISSIONERS CODED
 416 North State Street
 Jackson, Mississippi 39201
 WATER WELL DRILLERS LOG

6-29-1973 date well completed
 Bob Smith firm name
 Tate county well located

LANDOWNER:

B. H. McAnally

Snatchie - Miss.
 (mailing address)

description of formations encountered

clay silt

from 0 to 12

white sand

12 90

WELL LOCATION:

sec. 24 T 5 N R 7 E
 (S) (W)
 4 miles East of Senatobia
 (distance) (direction) (nearest town)

WELL PURPOSE: Home
 (home, irrigation, municipal, industrial)

WELL COMPLETION DATA:

- (1) diameter (inches) 4
 (2) total depth (feet) 90
 (3) static water level (feet) 30 below top of ground.
 (4) casing Plastic 90
 (material) (depth)

If telescope see back.
 (size)

- (5) screen 20 70
 (length) (depth to top)
 4 Plastic
 (size) (material)

- (6) pump 1/2 10
 (HP) (yield gpm)
 Elee
 (type power)

- (7) electric log 70
 (yes or no)

(organization running log)

- (8) how well bottom plugged
 plugged


CODED

DRILLERS REMARKS:

SEP 27 1973

If well telescopes please sketch and show depths.

GROUND LEVEL

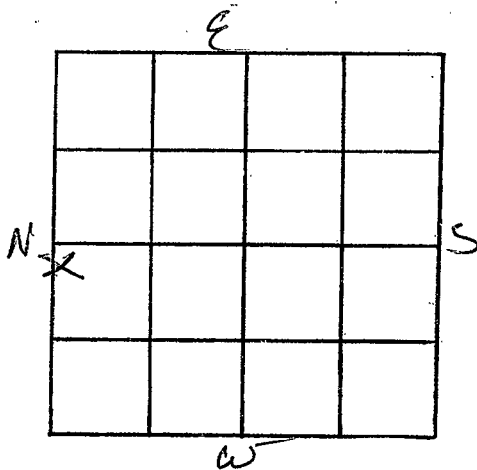

SECTION 20

Please indicate well location X.

ADDITIONAL INFORMATION

If more than one screen, show locations of each on sketch.