

TATE
G 70
12-26-73

MISSISSIPPI
BOARD OF WATER COMMISSIONERS
416 North State Street
Jackson, Mississippi 39201

CODED

WATER WELL DRILLERS LOG


12-26-1973 date well completed Bob Smith firm name Tate county well located

LANDOWNER:	description of formations encountered	from	to
Robt. Joney Snatobia, Miss. (mailing address)	Top Soil red clay red sand red gravel white clay white sand	0 5 15 25 35 60	5 15 25 35 60 150
WELL LOCATION: sec. 35 T 5 N R 7 E 3 miles S of New Town (distance) (direction) (nearest town)	CODED		
WELL PURPOSE: Home (home, irrigation, municipal, industrial)			
WELL COMPLETION DATA: (1) diameter (inches) 4 (2) total depth (feet) 150 (3) static water level (feet) 70 below top of ground. (4) casing (material) Plastic (depth) 150 (size) if telescope see back. (5) screen (length) 20 (depth to top) 130 (size) 4 (material) Plastic (6) pump 3/4 (HP) (yield) (type power) Electric (7) electric log 70 (yes or no) (organization running log)			
(8) how well bottom plugged DRILLERS REMARKS:			

MISSISSIPPI
BOARD OF WATER COMMISSIONERS
JAN 24 1974

If well telescopes please sketch and show depths.

GROUND LEVEL

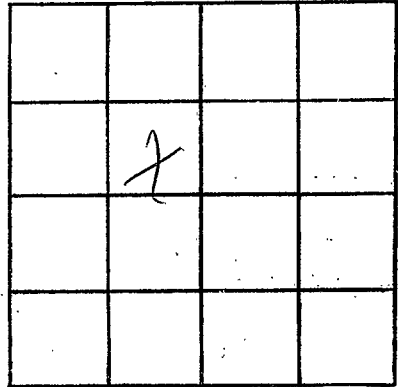

SECTION 35

Please indicate well location X.

ADDITIONAL INFORMATION

If more than one screen, show locations of each on sketch.