

TATE
G 71
5-29-74

MISSISSIPPI
BOARD OF WATER COMMISSIONERS
416 North State Street
Jackson, Mississippi 39201

CODED

WATER WELL DRILLERS LOG

5-29 1974 Bob Smith and Son Tate
date well completed firm name county well located

LANDOWNER: Ernest Archer	description of formations encountered	from	to
Route 2, Box 163	Brown clay	0'	15'
Coldwater, Miss. (mailing address)	Gravel	15'	25'
	Red Sand	25'	50'
	Fines white sand	50'	130'
	Coarse white sand	130'	160'

WELL LOCATION:
sec. 16 T 5 N R 7 E
2 miles S of Coldwater
(distance) (direction) (nearest town)

WELL PURPOSE: Home
(home, irrigation, municipal, industrial)

- WELL COMPLETION DATA:
- (1) diameter (inches) 4
 - (2) total depth (feet) 160
 - (3) static water level (feet) 100 below top of ground.
 - (4) casing Plastic, 160
(material) (depth)
(size) If telescope see back.
 - (5) screen 10, 150
(length) (depth to top)
4, Plastic
(size) (material)
 - (6) pump 1/2, 10
(HP) (yield gpm)
Electric
(type power)
 - (7) electric log no
(yes or no)

(organization running log)
 - (8) how well bottom plugged plugged


CODED

DRILLERS REMARKS:

MISSISSIPPI BOARD OF WATER COMMISSIONERS
JUL 24 1974

If well telescopes please sketch and show depths.

GROUND LEVEL

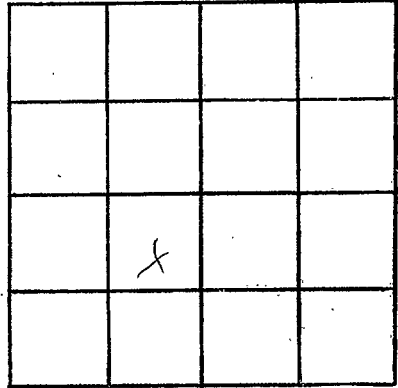

SECTION 16

Please indicate well location X.

ADDITIONAL INFORMATION

If more than one screen,
show locations of each on sketch.