

**MISSISSIPPI
BOARD OF WATER COMMISSIONERS**
416 North State Street
Jackson, Mississippi 39201

WATER WELL DRILLERS LOG

CODED

Fate
Panola
county well located

LATE
G 72
7-30-73

7-30-73
date well completed

Bob Smith
firm name

LANDOWNER:

R. D. Stung

Snatobia - miss.
(mailing address)

description of formations encountered

clay dirt

from 0 to 10

hard sand

10 50

gravel

50 65

hard sand

65 70

blue clay

70 115

white sand

115 150

WELL LOCATION:

sec. 35 T 5 N R 7 E
(S) (W)
3 miles S of New Town
(distance) (direction) (nearest town)

WELL PURPOSE: None
(home, irrigation, municipal, industrial)

WELL COMPLETION DATA:

- (1) diameter (inches) 4
- (2) total depth (feet) 150
- (3) static water level (feet) 90 below top of ground.
- (4) casing Plastic 150
(material) (depth)
(size) if telescope see back.
- (5) screen 20 130
(length) (depth to top)
4 Plastic
(size) (material)
- (6) pump 1/2 10
(HP) (yield gpm)
Elec
(type power)
- (7) electric log no
(yes or no)
(organization running log)
- (8) how well bottom plugged plugged

CODED


RECORDED
INDEXED
MAY 24 1974

MISS. DE. OF WATER COMMISSIONERS

DRILLERS REMARKS:

If well telescopes please sketch and show depths.

GROUND LEVEL

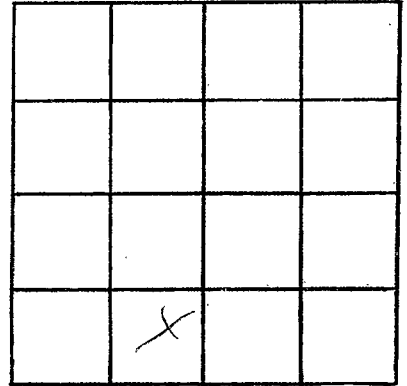

SECTION 35

Please indicate well location X.

ADDITIONAL INFORMATION

If more than one screen,
show locations of each on sketch.