

Jim Reppel Well Drilling & Repair Service 6663

MISSISSIPPI  
BOARD OF WATER COMMISSIONERS  
416 North State Street  
Jackson, Mississippi 39201

CODED

WATER WELL DRILLERS LOG

LATE  
G 74  
5-31-74

May 31 1974 Tate County Corp Tate  
date well completed firm name county well located

LANDOWNER: Tate County

description of formations encountered from to

PO Box 217, Senoia, Miss.  
(mailing address)

6663 74 5'0  
Black Gravel Sand 0 50  
Sh 0 50 63

WELL LOCATION:

sec. 5 T 5 N R 7 E  
1/2 miles South of Colma  
(distance) (direction) (nearest town)

WELL PURPOSE: Domestic  
(home, irrigation, municipal, industrial)

WELL COMPLETION DATA:

- (1) diameter (inches) 2 3/4
- (2) total depth (feet) 63
- (3) static water level (feet) 30 below top of ground.
- (4) casing gal 63  
(material) (depth)
- 2 If telescope see back.  
(size)
- (5) screen 6' x 2' 63  
(length) (depth to top)
- 1/2 gal  
(size) (material)
- (6) pump 2 250 gpm  
(HP) (yield gpm)

CODED

(7) electric log (yes or no)  
(organization running log)

(8) how well bottom plugged open

DRILLERS REMARKS: Jim Reppel


RECEIVED  
RECEIVED

JAN 2 1975

MISS. RD. OF WATER COMMISSIONERS

If well telescopes please sketch and show depths.

GROUND LEVEL

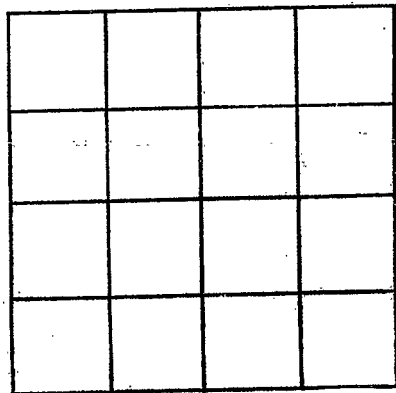

SECTION \_\_\_\_\_

Please indicate well location X.

ADDITIONAL INFORMATION

If more than one screen, show locations of each on sketch.