

TATE  
G 75  
4-4-75

MISSISSIPPI  
BOARD OF WATER COMMISSIONERS  
416 North State Street  
Jackson, Mississippi 39201

CODED

WATER WELL DRILLERS LOG

4-4-1975 Shapiro Well Co. Tate  
date well completed firm name county well located

LANDOWNER: M. P. Moore

description of formations encountered

from

to

Senatobia, Miss.

(mailing address)

|                                |           |            |
|--------------------------------|-----------|------------|
| <u>Red clay</u>                | <u>0</u>  | <u>15</u>  |
| <u>Gravel</u>                  | <u>15</u> | <u>45</u>  |
| <u>Black clay + Gravel</u>     | <u>45</u> | <u>60</u>  |
| <u>Black clay</u>              | <u>60</u> | <u>75</u>  |
| <u>Black clay + White Sand</u> | <u>75</u> | <u>90</u>  |
| <u>White Sand</u>              | <u>90</u> | <u>144</u> |

WELL LOCATION:

sec 19 T 5 N R 7 E  
34 miles N of Senatobia  
(distance) (direction) (nearest town)

WELL PURPOSE: drinking  
(home, irrigation, municipal, industrial)

WELL COMPLETION DATA:

- (1) diameter (inches) 4 in.
- (2) total depth (feet) 144
- (3) static water level (feet) 60 below above top of ground.
- (4) casing Plastic, 144  
(material) (depth)
- (size) if telescope see back.
- (5) screen 4 ft, 140  
(length) (depth to top)  
4 in. Gravel  
(size) (material)
- (6) pump 1/2 10  
(HP) (yield gpm)
- Electric 220  
(type power)
- (7) electric log No  
(yes or no)

(organization running log)


(8) how well bottom plugged cap

DRILLERS REMARKS:

RECEIVED  
MAY 23 1975

If well telescopes please sketch and show depths.

GROUND LEVEL

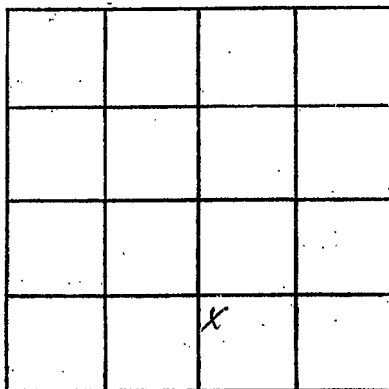

SECTION 19

Please indicate well location X.

ADDITIONAL INFORMATION

If more than one screen, show locations of each on sketch.