

Date
 6-27
 6-2-75


MISSISSIPPI
 BOARD OF WATER COMMISSIONERS
 416 North State Street
 Jackson, Mississippi 39201

CODED

WATER WELL DRILLERS LOG

6-2 1975 date well completed
 Burns Well Co. firm name
 Tate county well located


LANDOWNER:	description of formations encountered	from	to
(mailing address)			
William's Pullen	Red clay	0	15
Rt 1, Senatobia, Miss	Red Sand + Gravel	15	30
WELL LOCATION: sec 35 T 5 N R 7 E 156	Red Sand + Red Clay	30	45
1 miles S of Myrtle	Red Sand + Red Clay	45	60
WELL PURPOSE: <u>drinking</u> (home, irrigation, municipal, industrial)	white sand	60	128
WELL COMPLETION DATA:			
(1) diameter (inches) <u>4 1/2</u>			
(2) total depth (feet) <u>128</u>			
(3) static water level (feet) <u>95</u> below top of ground.			
(4) casing <u>Plastic</u> , <u>128</u> (material) (depth)			
(size) if telescope see back.			
(5) screen <u>4 ft</u> , <u>124</u> (length) (depth to top)			
<u>4 1/2</u> , <u>Gravel</u> (size) (material)			
(6) pump <u>1/2</u> , <u>10</u> (HP) (yield gpm)			
<u>Electric</u> <u>250</u> (type power)			
(7) electric log <u>no</u> (yes or no)			
(organization running log)			
(8) how well bottom plugged <u>Cap</u>			
DRILLERS REMARKS:			

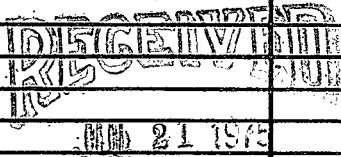

MISS. BD. OF WATER COMMISSIONERS

If well telescopes please sketch and show depths.

GROUND LEVEL

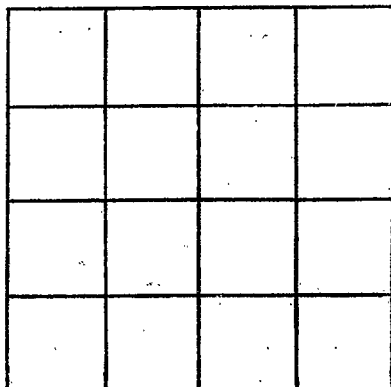

SECTION _____

Please indicate well location X.

ADDITIONAL INFORMATION

If more than one screen, show locations of each on sketch.