

MISSISSIPPI
BOARD OF WATER COMMISSIONERS
416 North State Street
Jackson, Mississippi 39201

CODED

WATER WELL DRILLERS LOG

Late
G 78
11-1-74

11-1 1974 Harris Bros. Late
date well completed firm name county well located

LANDOWNER Larry Littlejohn
Rt 2
Coldwater
(mailing address)

| description of formations encountered | from | to |
|---------------------------------------|------------|------------|
| <u>top soil</u> | <u>0</u> | <u>20</u> |
| <u>red sand</u> | <u>20</u> | <u>45</u> |
| <u>clay + sand</u> | <u>45</u> | <u>120</u> |
| <u>Coarse sand</u> | <u>120</u> | <u>140</u> |

WELL LOCATION:
sec. 15 T. 5 N. R. 7 E. 15E
2 1/2 miles N of Newtown
(distance) (direction) (nearest town)

WELL PURPOSE: home
(home, irrigation, municipal, industrial)

- WELL COMPLETION DATA:
- (1) diameter (inches) 4
 - (2) total depth (feet) 140
 - (3) static water level (feet) 80 ~~below~~ above top of ground.
 - (4) casing Plastic, 133,
(material) (depth)
4 if telescope see back.
(size)
 - (5) screen 7, 133
(length) (depth to top)
008, plastic
(size) (material)
 - (6) pump 3/4, 1
(HP) (yield gpm)
elec
(type power)
 - (7) electric log no
(yes or no)
 - (8) how well bottom plugged solid

CODED


RECEIVED
OCT 10 1974

DRILLERS REMARKS:

MISS. BD. OF WATER COMMISSIONERS

If well telescopes please sketch and show depths

GROUND LEVEL

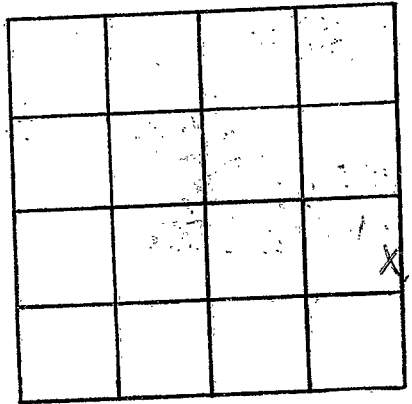

SECTION 15

Please indicate well location X.

ADDITIONAL INFORMATION

If more than one screen, show locations of each on sketch.