

TATE
G-79
3-19-80
3-19

MISSISSIPPI
BOARD OF WATER COMMISSIONERS
416 North State Street
Jackson, Mississippi 39201

CODED

WATER WELL DRILLERS LOG

1980 Nicho Well Co. Tate

date well completed

firm name

county well located

LANDOWNER:
Joe Taylor
P.O. 2, Coldwater Miss.
(mailing address)

description of formations encountered

from

to

WELL LOCATION:
sec. 13 T-5 N R-7 E
4 miles W of Brantley Miss.
(distance) (direction) (nearest town)

Clay	0	30
red sand	30	90
white sand	90	140

WELL PURPOSE: Home
(home, irrigation, municipal, industrial)

WELL COMPLETION DATA:

- (1) diameter (inches) 4 in
- (2) total depth (feet) 140
- (3) static water level (feet) 80 below top of ground.
- (4) casing 4" Plastic 140 (material) (depth)
- (size) if telescope see back.
- (5) screen 21 119 (length) (depth to top)
4 in gravel (size) (material)
- (6) pump 2 25 (HP) (yield gpm)
220 (type power)
- (7) electric log No (yes or no)

CODED

(organization running log)

(8) how well bottom plugged Cap

DRILLERS REMARKS:


DEPT. OF NATURAL RESOURCES
BUREAU OF LAND & WATER RESOURCES

APR - 9 1980

RECEIVED

If well telescopes please sketch and show depths.

GROUND LEVEL

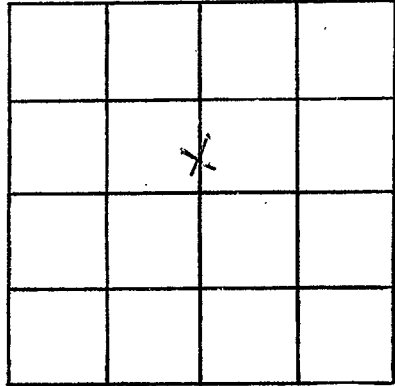

SECTION 13

Please indicate well location X.

ADDITIONAL INFORMATION

If more than one screen,
show locations of each on sketch.