

MISSISSIPPI DEPARTMENT OF NATURAL RESOURCES

Bureau of Land and Water Resources

Southport Mall

P.O. Box 10631

Jackson, Mississippi 39209

WATER WELL DRILLERS LOG

CODED

Tate  
G 81  
3-25-81

3-25 1981 date well completed

Hick Well Co. firm name

Tate county well located

LANDOWNER: Claude G. Gable  
1 Rt. 3  
Senatobia, Mo.  
(mailing address)

description of formations encountered	from	to
Red Sand	0	15
Gravel	15	65
white sand	65	140

WELL LOCATION:  
sec 27 T 5 N R 7 E  
1 miles E of Senatobia  
(distance) (direction) (nearest town)

WELL PURPOSE: Home  
(home, irrigation, municipal, industrial)

- WELL COMPLETION DATA:
- (1) diameter (inches) 4
  - (2) total depth (feet) 140
  - (3) static water level (feet) 103 below above top of ground.
  - (4) casing PVC 140  
(material) (depth)
  - (size) If telescope see back.
  - (5) screen 12 128  
(length) (depth to top)
  - (size) 4" (material) gravel & slotted
  - (6) pump 1/2 10  
(HP) (yield gpm)
  - (type power) 220v
  - (7) electric log No  
(yes or no)
  - (organization running log)
  - (8) how well bottom plugged Cap



DEPT. OF NATURAL RESOURCES  
BUREAU OF LAND & WATER RESOURCES


APR 18 1981

RECEIVED

DRILLERS REMARKS:

If well telescopes please sketch and show depths.

GROUND LEVEL

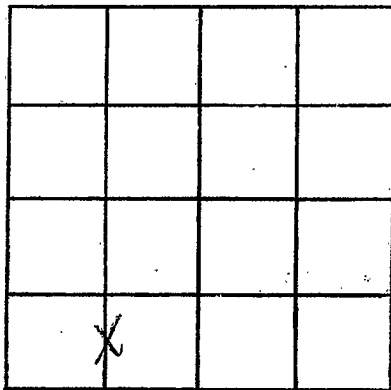

SECTION 27

Please indicate well location X.

ADDITIONAL INFORMATION

If more than one screen,  
show locations of each on sketch.