


If well telescopes please sketch and show depths.

GROUND LEVEL

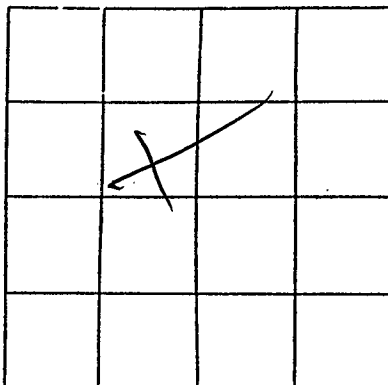

SECTION H-15

Please indicate well location X.

| Pump Capacity (GPM) | No. of Stages | Setting Depth |
|---------------------|---------------|---------------|
| <u>10</u> | <u>12</u> | <u>85</u> FT. |

PUMP TEST

Well yielded 12 GPM with
a drawdown of 3 ft.
after 1 hours of pumping

LOG DATA

TYPE OF LOG RUN (Circle One): No Log Run, Electric, Gamma Ray, Density, Sonic, Neutron, Other (Describe) _____

Name of Organization Running Log

GEOLOGIC DATA (Office Use Only)

| Surface Elev. | Geologic Unit | Unit Thickness | Depth to Top |
|---------------|---------------|----------------|--------------|
| Subs. SWL | Date | Analysis | Aquifer Test |

Driller's Remarks

If more than one screen, show location of each on sketch.