<u> </u>	State V	Vell Report			
County: Tate	Part 1 – Driller's Log		For Office Use Only:		
	Mississippi Department of Environmental Quality		Aquifer:		
Permit #:	Office of Land and Water Resources		Well #: 6-162		
Driller: Jones w. Moson	P.O. Box 2309		Well #: <u>6 / 6 / 7 / 6 / 7 / 6 / 7 / 6 / 7 / 6 / 7 / 6 / 7 / 7</u>		
		n, MS 39225 1961- 5210	L. S. Elevation:		
Date drilling completed: 8-20-08		61- 5228 (fax)			
			E-log #:		
State Law requires that this repor	t be prepared by the lic	ense holder responsible for i	he work and filed with the		
Department at the above address	within 30 days of comp				
Information on Well O (<i>Landowner if borehole is not fo</i>			rehole Location		
(Lundowner ty borenote is not jo	r a water well)	Latituda 34 . 40 . 30	8 Langitude, 89, 53, 996,		
Owner Name Jone Hersch	perger	Lantudes 1 19	Congrude: 54 An		
5538 - 1	CC 28 1		Conventional Survey,		
Mailing Address: 5528 peyt	on 19				
		USGS quad, Hand-held GPS Survey-grade GPS			
	2 8	SE 1/4 SE 1/4 Sec 2	Tum 55 Pmg 7(5)		
City State	38618		_ I WII KIIg 7 CC		
City State	e Zip Code	Distance Direction	Nearest Town		
Telephone No. (901) 490-1643	2	13/4 Miles Sw	of Antiach		
Totophone He. (13) 1 10 10 1					
	Well / Bore	hole Data			
8-20-08-			- 21		
Date drilling started: 8-70-08 Date dril	ling completed:	Hole depth: 475	Hole diameter: 6314		
Location of the source of any surface water	used for drilling.	^			
Method of dosing and volume of Chlorine	used in drilling and devel	opment: A A			
Logs run (circle all applicable). No log run	Electric Gamma Ray	Density Sonic Neutron (Other:		
Logs run (circle all applicable). No log run Electric Gamma Ray Density Sonic Neutron Other: Name of organization running log(s):					
Purpose of borehole (check one): Water Well Geotechnical/Geological Investigation Ground Source Heat Pump					
			Source Heat Fullip		
Seismic Survey Other (describe)					
If drilling is not related to water well construction, skip the remainder of this block					
Purpose of Well (check one): Home Industrial Public Supply Irrigation Y Fish Culture Other:					
			_ Other.		
If a flowing well, method of flow regulation: Valve Other (describe)					
Static Water Level: 109 feet above of below (circle one) land surface Date measured: 8-20-08					
Method of Measurement (circle one) steel tape electric tape air line other: 5tring [weight					
Well depth: 275 Well grouted to a depth of Sh. Sack T. S.					
Type of grout (circle one): Neat Cement Bentonite Mix					
Casing length: 355 feet Casing diameter: 4 inches Type of casing: puc					
Screen length:					
inches Type of screen:					
Screen slot size:					
Type of completion (circle all applicable): Gravel packed Underreamed Telescoped Open hole Natural Development					
Other (describe):					
Top of lap pipe or reduction in casing:feet. If telescoped or more than one screen, describe on next page					
ieet. If telescoped or more than one screen, describe on next page					
					

Form: OLWR-SWR-1A (04/08)

RECEIVED

SEP 1 9 2008

BY: OLWR

The sketch below only re	auired for water w	ells
--------------------------	--------------------	------


If well telescopes, show depths on sketch.

Ground Level

<u>Description of formations encountered must be provided for all wells and boreholes, unless specifically exempted by regulations</u>

Description of Formations Encountered	From (depth)	To (depth)
clay dirt	Ground Level	15
red soud	15	30
growel	30	60
while clar	60	90
white soud	90	95
Blue close	95	150
white sand	150	175
Blue clay	175	250
white sould	920	275
		i
		
		
		

If more than one screen, show location of each on sketch

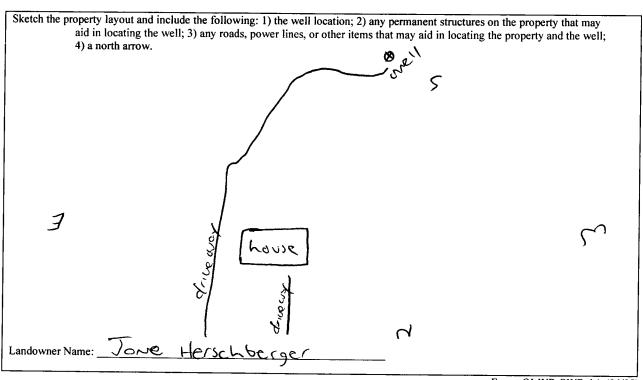

Form: OLWR-SWR-1A (04/08)

I certify that the well/borehole was drilled, constructed, and completed in accordance with all applicable requirements of the Mississippi Department of Environmental Quality and the Mississippi Department of Health regulations, if applicable, and state

Tones w. Mosan 0-620 9-17-08

Print Name of Responsible Licensee and License No. Date

Signature of Licensee

RECEIVED

SEP 1 9 2008

BY: OLWR

STATE WELL REPORT					
Permit #: Driller: Takes w. Masor Date completed: 8 20 - 08 Pump Installer' Mississippi Departmen Office of Land a P.O. Jackson (601)					
Well Owner Information	Well Location				
Owner Name: Jone Herschberger	Latitude: 34.40.308 Longitude: 89.53.996				
Mailing Address: 5528 peyton rd.	Method of Lat/Long (check one): Conventional Survey, USGS quad, Hand-held GPS, Survey-grade GPS				
1					
(oldwoter MS 38618) City State Zip Code	$SE_{4}SE_{4}Sec_{0}T_{5}SR_{0}T_{0}$				
City State Zip Code	Distance Direction Nearest Town				
Telephone No. (901) 490 - 1643	13/4 Miles 500 of Antiach				
Pump Type Circle one	Power Type Circle one				
Air Lift Jet Submersible	Diesel Engine Gasoline Engine Natural Gas				
Bucket Piston Turbine	Electric Motor Hand Tractor PTO				
Centrifugal Rotary Flowing Well	Windmill Other (specify):				
Other (specify):	Horse Power Rating of Motor:				
Date Pump Installed: 6-20-0 6	Setting Depth: 1 40 feet				
Rated Pump Capacity:Gallons Per Minute	Number of Stages: 14				
Pump Test Data	Method of Measuring Water Level				
Date Well Tested: 8-30-08	Circle one				
Static Water Level (A): 109 Feet Below Land Surface	Air Line Electric Measuring Line Steel Tape				
Pumping Water Level (B): Feet Below Land Surface	Other (specify): String I weight				
Drawdown [(B) – (A)]:Feet Below Land Surface	For flowing well, measured shut in head:feet				
Test Pumping Rate:Gallons Per Minute	Well yielded GPM with a drawdown of				
Duration of Pump Test (minimum 4 hours):hours	feet after 24 hours of pumping				
I HEREBY CERTIFY that the above statements are true to the best of my knowledge. form w. Man 0-620 Form: OLWR-SWFRET 40057 VED					

SEP 1 9 2008