

G 2000

6-61

WATER WELL DRILLERS LOG

G 300

Date: June, 1961, Driller: James Pickett County: Tate
 (Name)

(1) Owner of Land: W. Flowers
 (Name)
Colombia Miss
 (Address)

(2) Location: $\frac{1}{4}$, $\frac{1}{4}$, Sec 23 T5R17,
4 miles N. East, of Smethers
 (distance) (direction) (Nearest Town)

(3) Topography: 1
 (Hilly) (Flat) (Level)

(4) Purpose of Well: Domestic
 (Domestic Irrigation, Municipal, Industrial, Other)

| Description & Color of Materials Sand, Clay, Red Clay, Shell, etc. | Thick-ness Feet | Depth Feet |
|---|--------------------|---------------|
| <u>Red Clay First 10 ft</u> | | |
| <u>Blue Clay mud 20 ft</u> | | |
| <u>White Fine sand 1 ft</u> | | |
| | | |
| | | |
Information upon completion of well:

(1) Diameter 3 inches.

(2) Total Depth 96 feet.

(3) Water Level 30 feet below top of ground.

(4) Cased to _____, Size _____


(5) Screen: Size 90 ga, Length 1 ft

(6) Were any formations sealed against pollution?
 _____ yes, ✓ no.

If YES depth of formation _____

Why _____

Drillers Remarks: _____

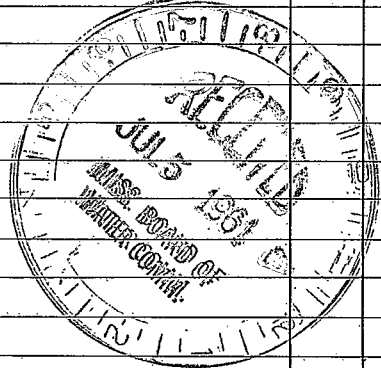

Well N

(Use Back Side)

SSIA