

G 2001
12-61

WATER WELL DRILLERS LOG

Date: Dec, 19 61, Driller: Small County Toledo
(Name)

(1) Owner of Land: J.M. Madala
(Name)
Snattah Rte 1
(Address)
S. 27 E
(2) Location: 1/4 SW 1/4, Sec 21 T52 R 2W
1 1/2 miles East of Snattah
(distance) (direction) (Nearest Town)
(3) Topography: X
(Hilly) (Flat) (Level)
(4) Purpose of Well: Home
(Domestic Irrigation, Municipal, Industrial, Other)


Description & Color of Materials Sand, Clay, Red Clay, Shell, etc.	Thick- ness Feet	Depth Feet
<u>Reddish silt</u>	<u>30</u>	
<u>Red silt & gravel</u>	<u>45</u>	
<u>White Clay & Sand</u>		
<u>mixed in the</u>		
<u>Next 30 feet about</u>		
<u>1/2 inch of Clay & about</u>		
<u>1/2 of sand</u>	<u>30</u>	
<u>Red sand</u>		
<u>sand</u>	<u>23</u>	

Information upon completion of well:

(1) Diameter 2 inches.
(2) Total Depth 128 feet.
(3) Water Level 110 feet below top of ground.
(4) Cased to _____, Size _____
(5) Screen: Size 6, Length 6
(6) Were any formations sealed against pollution?
_____ yes, 1 no.

If YES depth of formation _____
Why _____

Drillers Remarks: _____

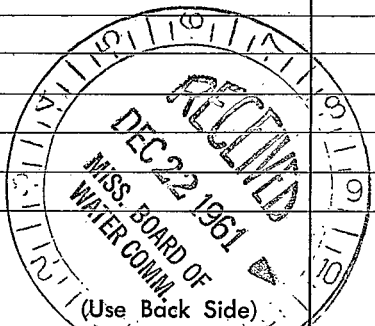

Well No. _____

