

Tate

MISSISSIPPI BOARD OF WATER COMMISSIONERS

G 2000

8-66

WATER WELL DRILLERS LOG

Date: Aug. 8, 1966, Driller: Shelby Meyman County Tate
(Name)

| (1) Owner of Land: | Description & Color of Materials Sand, Clay, Red Clay, Shell, etc. | Thick- ness Feet | Depth Feet |
|---|---|------------------------|---------------|
| Clyde Daniels (Name) Coldwater Miss. (Address) | Red Clay | 60 | 60 |
| NW 1/4, NW 1/4, Sec. 11, T5R7 (Location) 5 miles East of Coldwater (distance) (direction) (Nearest Town) | Red Sand & Gravel | 20 | 80 |
| Hilly (Hilly) (Flat) (Level) | Heavy Gravel | 40 | 120 |
| Purpose of Well: Domestic (Domestic Irrigation Municipal, Industrial, Other) | Red Sand | 10 | 130 |


Information upon completion of well:

- (1) Diameter 2 inches.
- (2) Total Depth 156 feet.
- (3) Water Level 97 feet below top of ground.
- (4) Cased to ~~_____~~, Size _____.
- (5) Screen: Size ~~_____~~ No. 6 Length 6 ft.
- (6) Were any formations sealed against pollution?
yes, no.

If YES depth of formation _____
Why _____

Drillers Remarks: _____

| | | |
|------------|----|-----|
| white clay | 4 | 134 |
| white sand | 22 | 156 |
| | | |
| | | |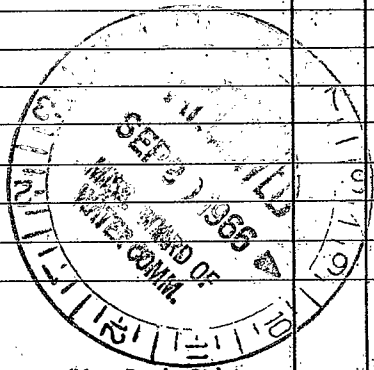
(Use Back Side)

Well No.

