

Date  
 G 2004  
 12-66

MISSISSIPPI  
 BOARD OF WATER COMMISSIONERS  
 416 North State Street  
 Jackson, Mississippi 39201

WATER WELL DRILLERS LOG

12-15 1966 Harris Bros. Tate  
 date well completed firm name county well located

LANDOWNER: James Smith  
 Rte. 2  
 Caldwellwater Miss  
 (mailing address)


description of formations encountered	from	to
top soil	0	20
gravel & sand	20	35
clay & sand	35	95
fine sand	95	120
coarse sand	120	135

WELL LOCATION:  
 sec. 1 T. 9 N. R. 7 E.  
 5 1/2 miles E of Caldwellwater  
 (distance) (direction) (nearest town)

WELL PURPOSE: home  
 (home, irrigation, municipal, industrial)

WELL COMPLETION DATA:

- (1) diameter (inches) 4
- (2) total depth (feet) 135
- (3) static water level (feet) 80 below top of ground.
- (4) casing Plastic, 128' (material) (depth)
- .008 #4 (size) if telescope see back.
- (5) screen 7' length, 128' depth to top  
 4" size, Plastic material
- (6) pump 3/4 HP, 7 yield gpm  
 elec. type power
- (7) electric log no (yes or no)  
 (organization running log)
- (8) how well bottom plugged well shot

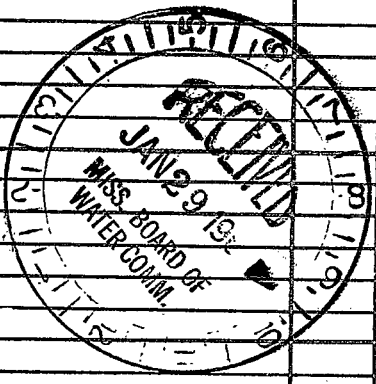

DRILLERS REMARKS:

If well telescopes please sketch and show depths.

GROUND LEVEL

		X	

SECTION 1

Please indicate well location X.

ADDITIONAL INFORMATION

If more than one screen, show locations of each on sketch.