

Late
G 2005
1-67

MISSISSIPPI
 BOARD OF WATER COMMISSIONERS
 416 North State Street
 Jackson, Mississippi 39201

WATER WELL DRILLERS LOG

1-20 1967 Harris Bros. Late
 date well completed firm name county well located


LANDOWNER: J.C. Gray
Rt. 1
Senatobia Miss.
 (mailing address)

description of formations encountered	from	to
<u>top soil</u>	<u>0</u>	<u>25</u>
<u>red sand</u>	<u>25</u>	<u>40</u>
<u>gray clay</u>	<u>40</u>	<u>85</u>
<u>sand & clay</u>	<u>85</u>	<u>125</u>
<u>white sand</u>	<u>125</u>	<u>140</u>

WELL LOCATION:
 sec. 35 T. 5 N. R. 7 E.
1/2 miles W of Senatobia
 (distance) (direction) (nearest town)

WELL PURPOSE: home
 (home, irrigation, municipal, industrial)


- WELL COMPLETION DATA:
- (1) diameter (inches) 4
 - (2) total depth (feet) 140
 - (3) static water level (feet) 80 below top of ground.
 - (4) casing plastic, 133' (material) (depth)
4 if telescope see back. (size)
 - (5) screen 7' (length) 133' (depth to top)
008 (size) plastic (material)
 - (6) pump 7/4 (HP) 7 (yield gpm)
elec. (type power)
 - (7) electric log no (yes or no)
 (organization running log)
 - (8) how well bottom plugged check sheet

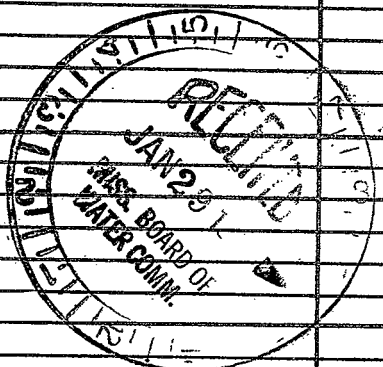

DRILLERS REMARKS:

If well telescopes please sketch and show depths.

GROUND LEVEL

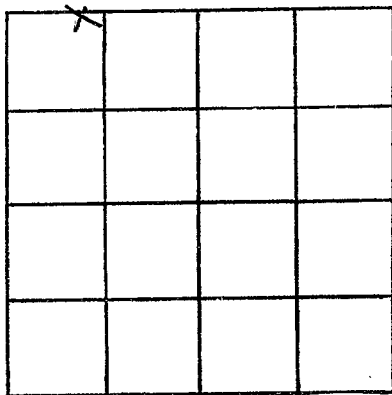

SECTION 35

Please indicate well location X.

ADDITIONAL INFORMATION

If more than one screen,
show locations of each on sketch.