

Date
 19 2006
 2-67

MISSISSIPPI
 BOARD OF WATER COMMISSIONERS
 416 North State Street
 Jackson, Mississippi 39201

WATER WELL DRILLERS LOG

2-25 19 67 date well completed
 Harris Bros. firm name
 Tate county well located

LANDOWNER: M.P. McKie
Rte. 1
Senatobia, Miss.
 (mailing address)


description of formations encountered	from	to
top soil	0	20
pea gravel	20	60
white clay & sand	60	125
sand	125	140

WELL LOCATION:
 sec 31 T S N R 7 E
 (S) (W)
1 miles W of Senatobia
 (distance) (direction) (nearest town)

WELL PURPOSE: home
 (home, irrigation, municipal, industrial)


- WELL COMPLETION DATA:
- (1) diameter (inches) 4
 - (2) total depth (feet) 140
 - (3) static water level (feet) 80 below above top of ground.
 - (4) casing Plastic, 133'
 (material) (depth)
4"
 (size) if telescope see back.
 - (5) screen 7', 133'
 (length) (depth to top)
208, Plastic
 (size) (material)
 - (6) pump 3/4 10
 (HP) (yield gpm)
elec.
 (type power)
 - (7) electric log no
 (yes or no)
 (organization running log)
 - (8) how well bottom plugged well
shot

DRILLERS REMARKS:

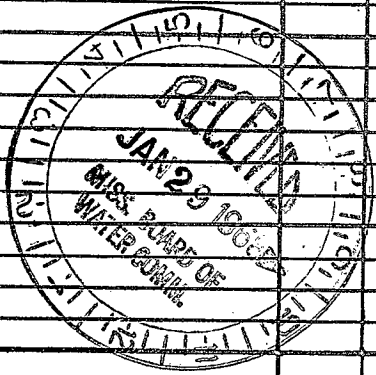

If well telescopes please sketch and show depths.

GROUND LEVEL

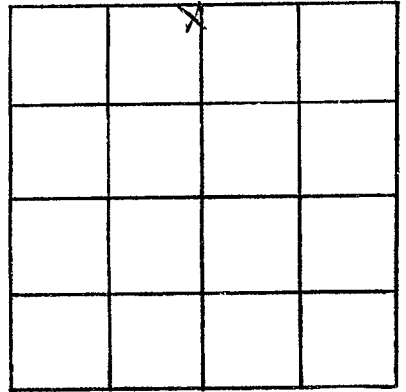

SECTION 31

Please indicate well location X.

ADDITIONAL INFORMATION

If more than one screen, show locations of each on sketch.