

Late
G 2007
7-67

MISSISSIPPI
 BOARD OF WATER COMMISSIONERS
 416 North State Street
 Jackson, Mississippi 39201

WATER WELL DRILLERS LOG

7-20 19 67 Hamm Bros. Late
 date well completed firm name county well located

LANDOWNER: Barry Childress
Rto 1
Senatobia, Miss.
 (mailing address)


description of formations encountered	from	to
<u>Top Soil</u>	<u>0</u>	<u>15</u>
<u>red sand</u>	<u>15</u>	<u>40</u>
<u>W/ clay & fine sand</u>	<u>40</u>	<u>90</u>
<u>hard sand</u>	<u>90</u>	<u>105</u>
<u>Coarse white sand</u>	<u>105</u>	<u>120</u>

WELL LOCATION:
 sec 27 T S N R 7 E
1 1/2 miles E of Senatobia
 (distance) (direction) (nearest town)

WELL PURPOSE: none
 (home, irrigation, municipal, industrial)

- WELL COMPLETION DATA:
- (1) diameter (inches) 4"
 - (2) total depth (feet) 120'
 - (3) static water level (feet) 80' below top of ground.
 - (4) casing Plastic, 113' (material) (depth)
4" (size) if telescope see back.
 - (5) screen 7', 113' (length) (depth to top)
.008, Plastic (size) (material)
 - (6) pump 3/4, 10 (HP) (yield gpm)
elec. (type power)
 - (7) electric log no (yes or no)
 (organization running log)
 - (8) how well bottom plugged Buck
shot

DRILLERS REMARKS:

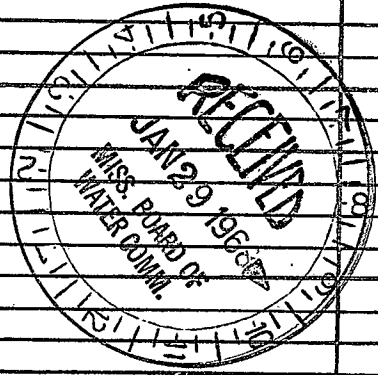

If well telescopes please
sketch and show depths.

GROUND LEVEL

			X

SECTION 27

Please indicate well location X.

ADDITIONAL INFORMATION

If more than one screen,
show locations of each on sketch.