

Late
G 2002
1-68

MISSISSIPPI
 BOARD OF WATER COMMISSIONERS
 416 North State Street
 Jackson, Mississippi 39201

WATER WELL DRILLERS LOG

Jan 31 1968 Shelby R Nymman Late
 date well completed firm name county well located

LANDOWNER: Reuben Wright
Rt 7, Dr - 2
Coldwater Miss.
 (mailing address)


description of formations encountered	from	to
<u>Red Sand & Gravel</u>	<u>0</u>	<u>115</u>
<u>Heavy Rock</u>	<u>115</u>	<u>121</u>
<u>White Sand</u>	<u>121</u>	<u>133</u>

WELL LOCATION:
 sec. 9 T. 5 N R. 7 E
4 1/2 miles East of Coldwater Miss.
 (distance) (direction) (nearest town)

WELL PURPOSE: Home
 (home, irrigation, municipal, industrial)

WELL COMPLETION DATA:

- (1) diameter (inches) 2
- (2) total depth (feet) 133
- (3) static water level (feet) 98 below top of ground.
- (4) casing 2 in Gal, 126 ft
 (material) (depth)
- _____ If telescope see back.
 (size)
- (5) screen 6 ft _____
 (length) (depth to top)
90 _____
 (size) (material)
- (6) pump 1 1/2 _____
 (HP) (yield gpm)
Electric
 (type power)
- (7) electric log No
 (yes or no)
No
 (organization running log)
- (8) how well bottom plugged Rubber Seal

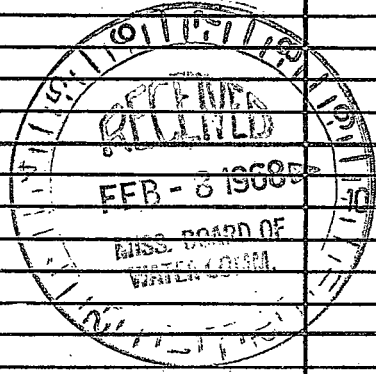


DRILLERS REMARKS:

If well telescopes please sketch and show depths.

GROUND LEVEL

Well

Sec 9-T5, R7

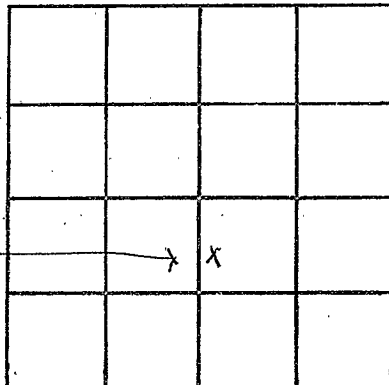

SECTION 9

Please indicate well location X.

ADDITIONAL INFORMATION

If more than one screen, show locations of each on sketch.