

TATE
 G 2009
 4-68

MISSISSIPPI
 BOARD OF WATER COMMISSIONERS
 416 North State Street
 Jackson, Mississippi 39201

WATER WELL DRILLERS LOG

April 30 1968 Shelby Nymmar Tate
 date well completed firm name county well located

LANDOWNER: Gary Wallace
 Coldwater
 Miss
 (mailing address)

description of formations encountered	from	to
Red clay	0	20
Red Gravel & Sand	20	140
Clear white Sand	140	154

WELL LOCATION:
 sec. 11 T. 5 N. R. 7 E.
 S W
 5 miles East of Coldwater
 (distance) (direction) (nearest town)

WELL PURPOSE: Home
 (home, irrigation, municipal, industrial)

- WELL COMPLETION DATA:
- (1) diameter (inches) 9
 - (2) total depth (feet) 154
 - (3) static water level (feet) 104 below top of ground.
 - (4) casing Galv. 147 (material) (depth)
 - 1 1/4" if telescope see back. (size)
 - (5) screen 6ft (length) (depth to top)
 - 1 1/4" Johnson R. B. 10568 (size) (material)
 - (6) pump 1/2 HP (HP) (yield gpm)
 - Electric (type power)
 - (7) electric log Yes (yes or no)
 - 20 (organization running log)
 - (8) how well bottom plugged Rubber Seal

MAY 10 1968


DRILLERS REMARKS:

MISS. BD. OF
 WATER COMM.

If well telescopes please sketch and show depths.

GROUND LEVEL

Well

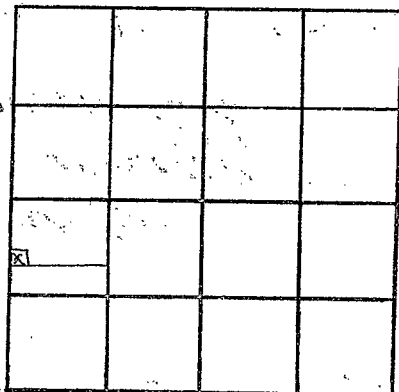

SECTION //

Please indicate well location X.

ADDITIONAL INFORMATION

If more than one screen, show locations of each on sketch.