

Date
 6-20-10
 6-68

MISSISSIPPI
 BOARD OF WATER COMMISSIONERS
 416 North State Street
 Jackson, Mississippi 39201

WATER WELL DRILLERS LOG

6-14-1968 *Bob Sells Well Co.* *Tate*
 date well completed firm name county well located

LANDOWNER: *Mills*
Coldwater, Miss.
 (mailing address)


description of formations encountered	from	to
<i>Top Soil</i>	<i>0</i>	<i>25</i>
<i>clay</i>	<i>25</i>	<i>75</i>
<i>Sand</i>	<i>75</i>	<i>120</i>

WELL LOCATION:
 sec. *2* T *5* N R *1* E
 (S) (W)
E miles *4* of *Coldwater*
 (distance) (direction) (nearest town)

WELL PURPOSE: *House*
 (home, irrigation, municipal, industrial)


- WELL COMPLETION DATA:
- (1) diameter (inches) *4*
 - (2) total depth (feet) *120*
 - (3) static water level (feet) *120* below above top of ground.
 - (4) casing *Plastic* *120'*
 (material) (depth)
 (size) if telescope see back.
 - (5) screen *RD* *100'*
 (length) (depth to top)
7 *Plastic*
 (size) (material)
 - (6) pump *1* *10*
 (HP) (yield gpm)
Elec.
 (type power)
 - (7) electric log *No*
 (yes or no)
 (organization running log)
 - (8) how well bottom plugged *Plugged*

DRILLERS REMARKS:
good drilling

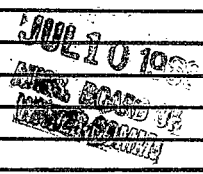

If well telescopes please sketch and show depths.

GROUND LEVEL

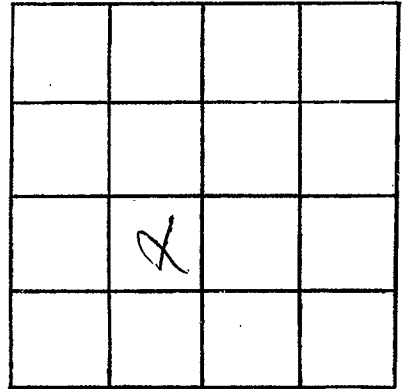

SECTION _____

Please indicate well location X.

ADDITIONAL INFORMATION

If more than one screen, show locations of each on sketch.