

Tate
 G 201
 12-5-75

MISSISSIPPI
 BOARD OF WATER COMMISSIONERS
 416 North State Street
 Jackson, Mississippi 39201

WATER WELL DRILLERS LOG

12-5-75 19 date well completed
 Hicks Well Co. firm name
 TATE county well located

LANDOWNER: M. P. Moore
 Senatobia, Miss
 (mailing address)

description of formations encountered	from	to
Red Clay	0	10
Red Sand & Gravel	10	40
White Sand + Clay	40	150
White Sand	150	209

WELL LOCATION:
 sec. 20 T 5 N R 9 E
 1/2 miles North of Senatobia
 (distance) (direction) (nearest town)

WELL PURPOSE: Home
 (home, irrigation, municipal, industrial)


- WELL COMPLETION DATA:
- (1) diameter (inches) 4"
 - (2) total depth (feet) 209
 - (3) static water level (feet) 40 below above top of ground.
 - (4) casing PVC, 209 (material) (depth)
 (size) If telescope see back.
 - (5) screen 7' 7' (length) (depth to top)
 4" Inside Gravel (size) (material)
 - (6) pump 1/2 (HP) 5 (yield, gpm)
 E/C. 220 (type power)
 - (7) electric log NO (yes or no)
 (organization running log)
 - (8) how well bottom plugged CAP

DRILLERS REMARKS:

DEC 22 1975
 MISS. BD. OF WATER COMM

If well telescopes please sketch and show depths.

GROUND LEVEL

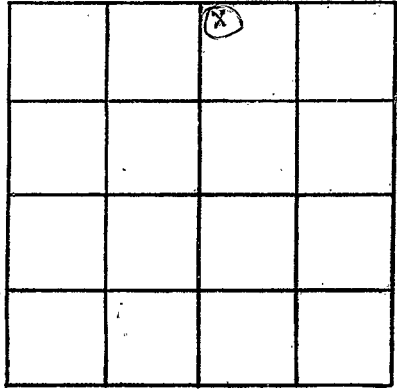

SECTION _____

Please indicate well location X.

ADDITIONAL INFORMATION

If more than one screen,
show locations of each on sketch.