

TATE
 G 2014
 4-1-76

MISSISSIPPI
 BOARD OF WATER COMMISSIONERS
 416 North State Street
 15E Jackson, Mississippi 39201

WATER WELL DRILLERS LOG

4-1 1976 HICKS WELL CO. TATE
 date well completed firm name county well located

LANDOWNER: Hickory G.R. BARCO
 Rt. 2
 Coldwater, Miss.
 (mailing address)

description of formations encountered	depth	
	from	to
RED CLAY	0	10
RED SAND	10	20
GRAVEL & SAND	20	65
White SAND	65	95

WELL LOCATION:
 sec. 12 T 50 S R 7 E
 6 miles E of Coldwater
 (distance) (direction) (nearest town)

WELL PURPOSE: CHURCH
 (home, irrigation, municipal, industrial)


- WELL COMPLETION DATA:
- (1) diameter (inches) 4"
 - (2) total depth (feet) 95
 - (3) static water level (feet) 70 below top of ground.
 - (4) casing PVC 88 (material) (depth) (size) If telescope see back.
 - (5) screen 71 71 (length) (depth to top)
 4" Inside GRAVEL (size) (material)
 - (6) pump 1/2 10 (HP) (yield gpm)
 2.2 (type power)
 - (7) electric log NO (yes or no)
 (organization running log)
 - (8) how well bottom plugged CAP

DRILLERS REMARKS:

DRILLERS PERMIT
 MAY 26 1976
 MISS. Bd. Of W. Comm.

If well telescopes please sketch and show depths.

GROUND LEVEL

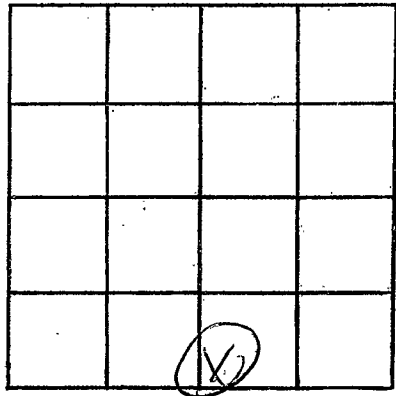

SECTION _____

Please indicate well location X.

ADDITIONAL INFORMATION

If more than one screen, show locations of each on sketch.