

TATE
 6 2015
 4-21-76

MISSISSIPPI
 BOARD OF WATER COMMISSIONERS
 416 North State Street
 Jackson, Mississippi 39201

WATER WELL DRILLERS LOG

4-21 1976
 date well completed

15E Hicks Well Co
 firm name

TATE
 county well located

LANDOWNER: Horace White
 Rt. 1
 Senatobia, Miss.
 (mailing address)


description of formations encountered	from	to
Red Clay	0	10
Red Sand	10	45
GRAVEL	45	90
White Sand	90	115

WELL LOCATION:
 sec. 2 T5S N R7WE
 S W
 2 miles E of Senatobia
 (distance) (direction) (nearest town)

WELL PURPOSE: Home
 (home, irrigation, municipal, industrial)


- WELL COMPLETION DATA:
- (1) diameter (inches) 4"
 - (2) total depth (feet) 115
 - (3) static water level (feet) 80 below top of ground.
 - (4) casing PVC, 108 (material) (depth)
 (size) if telescope see back.
 - (5) screen 7' 7' (length) (depth to top)
 4" Inside Gravel (size) (material)
 - (6) pump 1/2 (HP) 10 (yield gpm)
 220 (type power)
 - (7) electric log NO (yes or no)
 (organization running log)
 - (8) how well bottom plugged CAP

DRILLERS REMARKS:

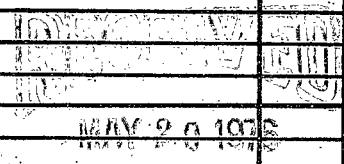

If well telescopes please sketch and show depths.

GROUND LEVEL

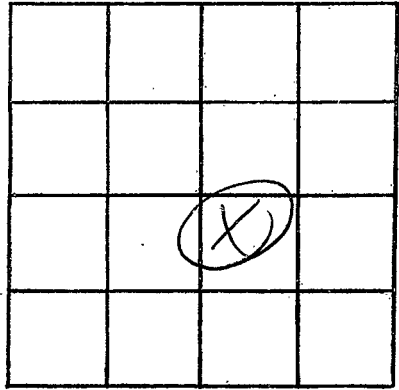

SECTION _____

Please indicate well location X.

ADDITIONAL INFORMATION

If more than one screen,
show locations of each on sketch.