

MISSISSIPPI  
BOARD OF WATER COMMISSIONERS  
416 North State Street  
Jackson, Mississippi 39201

WATER WELL DRILLERS LOG

Late  
G 204  
5-6-76

15E

5-6-1976  
date well completed

Harris Bros  
firm name

Late  
county well located

LANDOWNER: Robby Frazer  
At. 1  
Senatobia  
(mailing address)

description of formations encountered	from	to
<u>top soil</u>	<u>0</u>	<u>20</u>
<u>clay sand</u>	<u>20</u>	<u>25</u>
<u>Coarse sand</u>	<u>25</u>	<u>100</u>

WELL LOCATION:  
sec. 15 T. 5 N. R. 7 E.  
2 miles (distance) N (direction) of New Town (nearest town)

WELL PURPOSE: none  
(home, irrigation, municipal, industrial)

WELL COMPLETION DATA:

(1) diameter (inches) 4

(2) total depth (feet) 100

(3) static water level (feet) 10 below top of ground. above

(4) casing plastic (material), 93 (depth)

4 (size) if telescope see back.

(5) screen 7 (length), 93 (depth to top)

ool (size), plastic (material)

(6) pump 3/4 (HP), 10 (yield gpm)

elec (type power)

(7) electric log no (yes or no)

(organization running log)

(8) how well bottom plugged solid


**RECEIVED**  
OCT 22 1976

DRILLERS REMARKS:

MISS. BD. OF WATER COMM

If well telescopes please sketch and show depths.

GROUND LEVEL

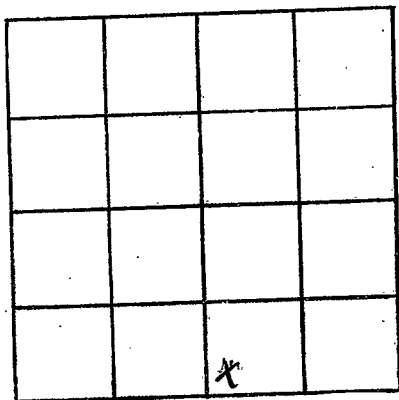

SECTION 15

Please indicate well location X.

ADDITIONAL INFORMATION

If more than one screen, show locations of each on sketch.