

Late
G 207
6-24-76

MISSISSIPPI
 BOARD OF WATER COMMISSIONERS
 416 North State Street
 Jackson, Mississippi 39201

WATER WELL DRILLERS LOG

6-24 1976 Hicks Well Co. Late
 date well completed firm name county well located

LANDOWNER: M. P. Moore

description of formations encountered

from

to

Senatobia, Miss.
 (mailing address)

| | | |
|-------------------|-----|-----|
| Red Clay | 0 | 10 |
| Red Sand & clay | 10 | 60 |
| White clay + sand | 60 | 140 |
| White Sand | 140 | 187 |

WELL LOCATION:

sec. 19 T. 5 N. R. 7 E.

1/4 miles N of Senatobia
 (distance) (direction) (nearest town)

WELL PURPOSE: Ranch
 (home, irrigation, municipal, industrial)

WELL COMPLETION DATA:

- (1) diameter (inches) 4"
- (2) total depth (feet) 187
- (3) static water level (feet) 80 below above top of ground.

(4) casing PVC, 187
 (material) (depth)

(size) if telescope see back.

(5) screen 4', 183
 (length) (depth to top)

4", Gravel
 (size) (material)

(6) pump 1/2, 10
 (HP) (yield. gpm)

220
 (type power)

(7) electric log NO
 (yes or no)

(organization running log)


(8) how well bottom plugged Cap

DRILLERS REMARKS:

JUL 1976
 MISSISSIPPI BOARD OF WATER COMMISSIONERS

If well telescopes please sketch and show depths.

GROUND LEVEL

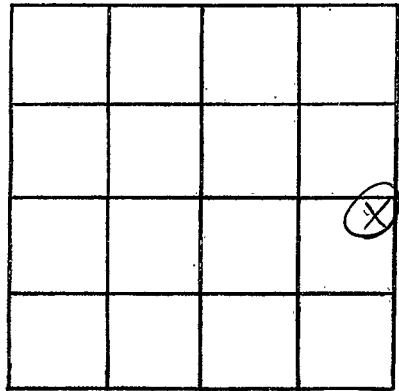

SECTION 79

Please indicate well location X.

ADDITIONAL INFORMATION

If more than one screen,
show locations of each on sketch.