

Date
 9 2018
 8-20-76

MISSISSIPPI
 BOARD OF WATER COMMISSIONERS
 416 North State Street
 Jackson, Mississippi 39201

15E

WATER WELL DRILLERS LOG

Date

8-20-76 19 Bob Littlewaters Date
 date well completed firm name county well located

LANDOWNER:
R. E. E. Lam
Caldwater, Ms.
 (mailing address)

description of formations encountered	from	to
top soil	0	5
red clay	5	60
gravel	60	100
blue clay	100	160
sand	160	205

WELL LOCATION:
 sec. 4 T. 5 N. R. 1 E.
3 miles E of Caldwater
 (distance) (direction) (nearest town)

WELL PURPOSE:
 (home) irrigation, municipal, industrial

WELL COMPLETION DATA:

(1) diameter (inches) 4"

(2) total depth (feet) 205

(3) static water level (feet) 130 below top of ground.

(4) casing plastic, 205
 (material) (depth)

(size) If telescope see back.

(5) screen 20, 185
 (length) (depth to top)

(size) plastic
 (material)

(6) pump 1/2, 10
 (HP) (yield gpm)

E see
 (type power)

(7) electric log (yes or no)

(organization running log)


(8) how well bottom plugged

RECEIVED
 SEP 20 1976

DRILLERS REMARKS:

If well telescopes please sketch and show depths.

GROUND LEVEL

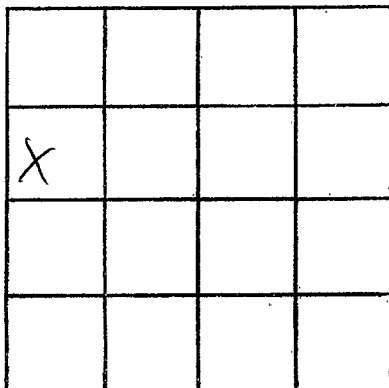

SECTION _____

Please indicate well location X.

ADDITIONAL INFORMATION

If more than one screen, show locations of each on sketch.