

late
G 2020
9-17-76

MISSISSIPPI
 BOARD OF WATER COMMISSIONERS
 416 North State Street
 Jackson, Mississippi 39201

WATER WELL DRILLERS LOG

9-17 1976 Shick Well Co TRD
 date well completed firm name county well located

LANDOWNER: <u>New Town Baptist Church</u>	description of formations encountered	from	to
<u>Rt. 1</u>			
<u>Senatobia, Miss.</u> (mailing address)	<u>Red Clay</u>	<u>0</u>	<u>10</u>
	<u>Red Sand</u>	<u>10</u>	<u>90</u>
	<u>White Sand</u>	<u>90</u>	<u>125</u>

WELL LOCATION:
 sec. 35 T 5 N R 7 E
1/2 miles E of New Town
 (distance) (direction) (nearest town)

WELL PURPOSE: Church
 (home, irrigation, municipal, industrial)


- WELL COMPLETION DATA:
- (1) diameter (inches) 4 1/2
 - (2) total depth (feet) 125
 - (3) static water level (feet) 80 below top of ground.
 - (4) casing PVC 125
 (material) (depth)
 (size) If telescope see back.
 - (5) screen 4 121
 (length) (depth to top)
4 1/2 gravel
 (size) (material)
 - (6) pump 1/2 10
 (HP) (yield gpm)
220V
 (type power)
 - (7) electric log No
 (yes or no)
- (organization running log)
- (8) how well bottom plugged Cap

DRILLERS REMARKS:

RECEIVED
 OCT - 5 1976

If well telescopes please
sketch and show depths.

GROUND LEVEL

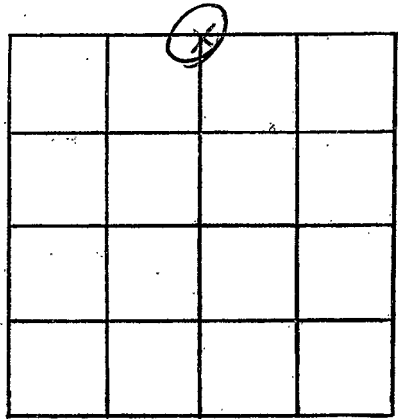

SECTION 35

Please indicate well location X.

ADDITIONAL INFORMATION

If more than one screen,
show locations of each on sketch.