

Tate
 G 2000
 10-4-76

MISSISSIPPI
 BOARD OF WATER COMMISSIONERS
 416 North State Street
 Jackson, Mississippi 39201

WATER WELL DRILLERS LOG

10-4-1976 ^{15E} Hoch Well Co. Tate
 date well completed firm name county well located

LANDOWNER: W. T. Newson
RT. 2
Senatobia, Miss.
 (mailing address)

description of formations encountered	from	to
Red Clay	0	20
Red Sand	20	65
Gravel + Sand	65	150
White Sand	150	175

WELL LOCATION:
 sec. 36 T. 5 N R. 8 E
1/2 miles SE of Senatobia
 (distance) (direction) (nearest town)

WELL PURPOSE: drinking
 (home, irrigation, municipal, industrial)

WELL COMPLETION DATA:
 (1) diameter (inches) 4
 (2) total depth (feet) 175
 (3) static water level (feet) 90 below above top of ground.
 (4) casing PVC, 175
 (material) (depth)
 (size) If telescope see back.
 (5) screen 4ft, 17ft
 (length) (depth to top)
4 in., Gravel
 (size) (material)
 (6) pump 1/2, 10
 (HP) (yield gpm)
220V
 (type power)
 (7) electric log No
 (yes or no)
 (organization running log)
 (8) how well bottom plugged. Cap


DRILLERS REMARKS:

RECEIVED
 JAN 5 1977

MISS. BD. OF WATER COMMISSIONERS

If well telescopes please sketch and show depths.

GROUND LEVEL

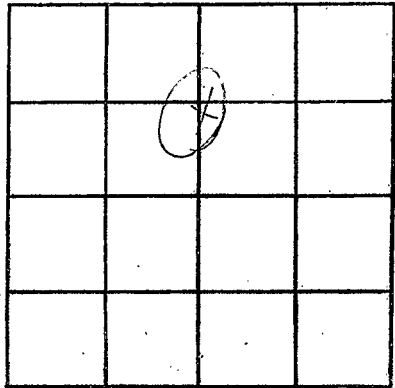

SECTION

36

Please indicate well location X.

ADDITIONAL INFORMATION

If more than one screen,
show locations of each on sketch.