

Tate
 G 200ft
 1-29-77

MISSISSIPPI
 BOARD OF WATER COMMISSIONERS
 416 North State Street
 Jackson, Mississippi 39201

WATER WELL DRILLERS LOG

1-29 1977 ¹⁵⁶ Hicks Well Co Tate
 date well completed firm name county well located

LANDOWNER: Genoy Richardson Jr.
 Pt. 1,
 Senatobia, Ms.
 (mailing address)

description of formations encountered	from	to
	White Clay	0
White Sand	40	135

WELL LOCATION:
 sec. 26-T-65 N R 7 E
1/2 miles S of Newtown
 (distance) (direction) (nearest town)

WELL PURPOSE: Home
 (home, irrigation, municipal, industrial)


- WELL COMPLETION DATA:
- (1) diameter (inches) 4
 - (2) total depth (feet) 135
 - (3) static water level (feet) 80 below above top of ground.
 - (4) casing PVC 135
 (material) (depth)
 - if telescope see back.
 (size)
 - (5) screen 4ft 131
 (length) (depth to top)
4" Drum Type
 (size) (material)
 - (6) pump 1/2 10
 (HP) (yield gpm)
220V
 (type power)
 - (7) electric log No
 (yes or no)
 - (organization running log)
 - (8) how well bottom plugged Cap

DRILLERS REMARKS:

RECEIVED
 FEB 24 1977
 MISS. BD. OF WATER CONTROL

If well telescopes please sketch and show depths.

GROUND LEVEL

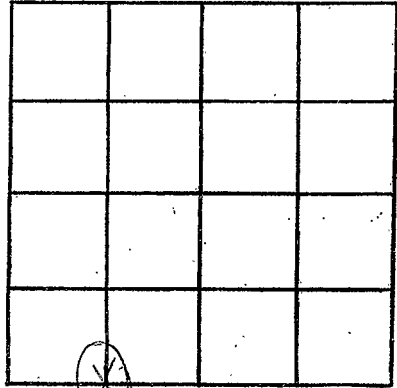

SECTION 26

Please indicate well location X.

ADDITIONAL INFORMATION

If more than one screen, show locations of each on sketch.