

Date
 3-24-77

MISSISSIPPI
 BOARD OF WATER COMMISSIONERS
 416 North State Street
 Jackson, Mississippi 39201

WATER WELL DRILLERS LOG

3-24-1977 date well completed
 15E Hecks Well Co. firm name
 Tate county well located

LANDOWNER: V.W. Cole
 Coldwater, Ms.
 (mailing address)

description of formations encountered	from	to
Red Clay	0	10
Red Sand	10	30
Red Sand + Rock	30	45
Gravel	45	90
White Clay + Sand	90	110
White Sand	110	145

WELL LOCATION:
 sec. 9 T. 5 N. R. 7 E.
 1 miles SE of Coldwater
 (distance) (direction) (nearest town)

WELL PURPOSE: Home
 (home, irrigation, municipal, industrial)

- WELL COMPLETION DATA:
- (1) diameter (inches) 4
 - (2) total depth (feet) 145
 - (3) static water level (feet) 130 below top of ground.
 - (4) casing PVC, 145 (material) (depth)
 - (5) screen 4' (length), 141 (depth to top)
 4" (size), Shovel type (material)
 - (6) pump 1/2 (HP), 10 (yield gpm)
 220V (type power)
 - (7) electric log No (yes or no)
 - (8) how well bottom plugged Cap


DRILLERS REMARKS:

RECEIVED
 APR 8 1977

MISS. BD. OF WATER COMMISSIONERS

If well telescopes please sketch and show depths.

GROUND LEVEL

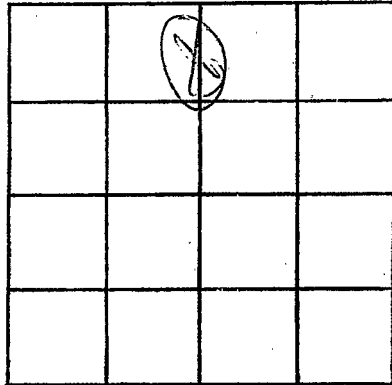

SECTION 9

Please indicate well location X.

ADDITIONAL INFORMATION

If more than one screen, show locations of each on sketch.