

Tate
 G 2057
 3/29/77

MISSISSIPPI
 BOARD OF WATER COMMISSIONERS
 416 North State Street
 Jackson, Mississippi 39201

WATER WELL DRILLERS LOG

3-29 1977 *Rich Well Co.* *Tate*
 date well completed firm name county well located

LANDOWNER: *Joe Taylor*
Rt. 2
Caldwater, Ms.
 (mailing address)

description of formations encountered	from	to
<i>Red Clay</i>	<i>0</i>	<i>20</i>
<i>Red Sand + Clay</i>	<i>20</i>	<i>40</i>
<i>White Sand</i>	<i>40</i>	<i>112</i>

WELL LOCATION:
 sec. *12* T. *5* N. R. *7* E.
3 miles *SW* of *Bozville*
 (distance) (direction) (nearest town)

WELL PURPOSE: *Home*
 (home, irrigation, municipal, industrial)

WELL COMPLETION DATA:
 (1) diameter (inches) *4*
 (2) total depth (feet) *112*
 (3) static water level (feet) *100* below top of ground.
 (4) casing *PVC*, *112*,
 (material) (depth)
 (size) if telescope see back.
 (5) screen *4'*, *108*
 (length) (depth to top)
4", *Shovel type*
 (size) (material)
 (6) pump *3/4*, *10*
 (HP) (yield gpm)
~~*220V*~~
 (type power)
 (7) electric log *No*
 (yes or no)
 (organization running log)
 (8) how well bottom plugged *Cap*


RECEIVED
 APR 8 1977

DRILLERS REMARKS:

MISS. DD. OF WATER COMMISSIONERS

If well telescopes please sketch and show depths.

GROUND LEVEL

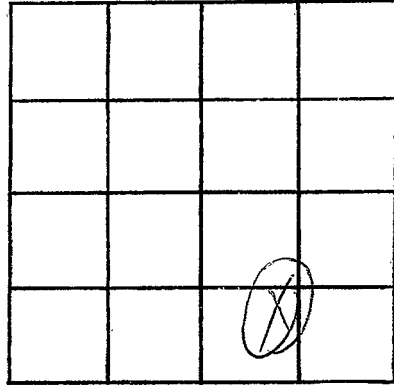

SECTION 12

Please indicate well location X.

ADDITIONAL INFORMATION

If more than one screen, show locations of each on sketch.