

TATE  
G 2027  
7-7-77

MISSISSIPPI  
BOARD OF WATER COMMISSIONERS  
416 North State Street  
156 Jackson, Mississippi 39201

WATER WELL DRILLERS LOG

7-7-77 date well completed      Hicks Well Co. firm name      Tate county well located

LANDOWNER: J.A. Miles  
Pt. 3  
Coldwater, Ms.  
(mailing address)

WELL LOCATION:  
sec. 10 T. 5 N. R. 7 E.  
7 miles E of Coldwater  
(distance) (direction) (nearest town)

WELL PURPOSE: Home  
(home, irrigation, municipal, industrial)

WELL COMPLETION DATA:  
(1) diameter (inches) 4  
(2) total depth (feet) 170  
(3) static water level (feet) 107 below top of ground.  
(4) casing PVC, 170 (material) (depth)  
(size) if telescope see back.  
(5) screen 7' (length) 163 (depth to top)  
4" gravel type (size) (material)  
(6) pump 42 10 (HP) (yield gpm)  
220V (type power)  
(7) electric log No (yes or no)  
(organization running log)  
(8) how well bottom plugged Cap

description of formations encountered	from	to
Red clay	0	40
Red sand	40	120
White sand	120	130
White sand, + clay	130	145
White sand	145	170

RECEIVED


OCT 17 1977

DRILLERS REMARKS:

MISS. BD. OF WATER COMM

If well telescopes please sketch and show depths.

GROUND LEVEL

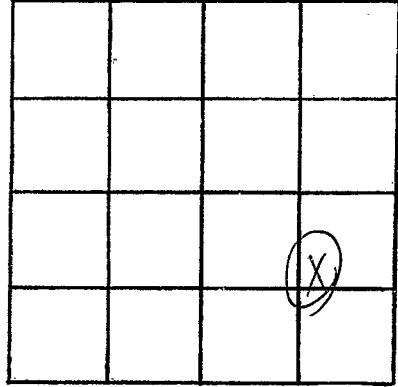

SECTION 10

Please indicate well location X.

ADDITIONAL INFORMATION

If more than one screen, show locations of each on sketch.