

TATE
G 2030
7-8-77

MISSISSIPPI
BOARD OF WATER COMMISSIONERS
416 North State Street
Jackson, Mississippi 39201

WATER WELL DRILLERS LOG

7-8 1977 Harris Bros. Tate
date well completed firm name county well located

LANDOWNER: J. W. Hawkins
Rt. 2 Box 68
Coldwater
(mailing address)

description of formations encountered	from	to
top soil	0	20
fine sand	20	60
clay + sand	60	140
course sand	140	160

WELL LOCATION:
sec. 9 T. 5 N. R. 7 E.
2 1/2 miles S of Coldwater
(distance) (direction) (nearest town)

WELL PURPOSE: home
(home, irrigation, municipal, industrial)

- WELL COMPLETION DATA:
- (1) diameter (inches) 4
 - (2) total depth (feet) 160
 - (3) static water level (feet) 100 below top of ground.
 - (4) casing Plastic, 146 (material) (depth)
4 (size) if telescope see back.
 - (5) screen 14 (length) 146 (depth to top)
008 Plastic (size) (material)
 - (6) pump 3/4 (HP) 10 (yield gpm)
elec. (type power)
 - (7) electric log No (yes or no)
 - (8) how well bottom plugged solid


DRILLERS REMARKS:

RECEIVED
SEP 30 1977

MISS. BD. OF WATER COMMISSIONERS

If well telescopes please sketch and show depths.

GROUND LEVEL

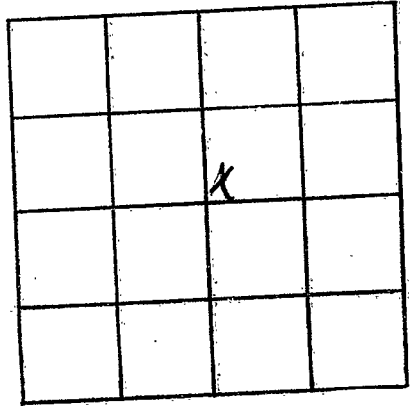

SECTION 9

Please indicate well location X.

ADDITIONAL INFORMATION

If more than one screen, show locations of each on sketch.