

TATE
G 2032
8-4-77

MISSISSIPPI
BOARD OF WATER COMMISSIONERS
416 North State Street
15E Jackson, Mississippi 39201

WATER WELL DRILLERS LOG

8-4-77 19 Hicks well ad TATE
date well completed firm name county well located

LANDOWNER: M. P. Ingram
Rt. 2 Coldwater
(mailing address)

description of formations encountered	from	to
<u>Red clay</u>	<u>0</u>	<u>40</u>
<u>Red sand</u>	<u>40</u>	<u>60</u>
<u>WS & clay</u>	<u>60</u>	<u>130</u>
<u>W-S</u>	<u>130</u>	<u>157</u>

WELL LOCATION:
sec. 2 T. 5 N. R. 7 E
4 miles E of Coldwater
(distance) (direction) (nearest town)

WELL PURPOSE: Home
(home, irrigation, municipal, industrial)

- WELL COMPLETION DATA:
- (1) diameter (inches) 4"
 - (2) total depth (feet) 157'
 - (3) static water level (feet) 130 below top of ground.
 - (4) casing PVC, 150,
(material) (depth)
(size) If telescope see back.
 - (5) screen 7', 7'
(length) (depth to top)
4", insale Reob
(size) (material)
 - (6) pump 3/4, 10
(HP) (yield gpm)
Elec.
(type power)
 - (7) electric log (yes or no) _____
(organization running log) _____
 - (8) how well bottom plugged cap


DRILLERS REMARKS:

RECEIVED
AUG 18 1977

MISS. BD. OF WATER COMMISSIONERS

If well telescopes please sketch and show depths.

GROUND LEVEL

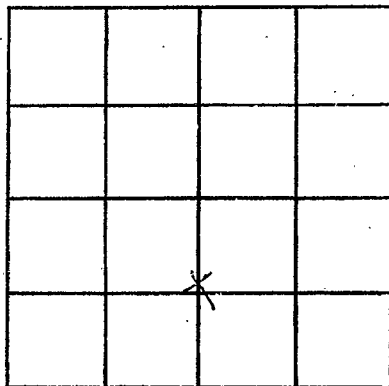

SECTION _____

Please indicate well location X.

ADDITIONAL INFORMATION

If more than one screen, show locations of each on sketch.