

**TATE**  
 5 2034  
 10/24/77

MISSISSIPPI  
 BOARD OF WATER COMMISSIONERS  
 416 North State Street  
 Jackson, Mississippi 39201

WATER WELL DRILLERS LOG

10-24 1977 *Harries Bros* *Tate*  
 date well completed firm name county well located

LANDOWNER: *Paul Baddour*  
 Rt. 1  
*Senatobia*  
 (mailing address)

WELL LOCATION:  
 sec. 35 T 5 N R 7 E  
 2 1/2 miles NE of Senatobia  
 (distance) (direction) (nearest town)

WELL PURPOSE: *irrigation*  
 (home, irrigation, municipal, industrial)

WELL COMPLETION DATA:

(1) diameter (inches) 4

(2) total depth (feet) 130

(3) static water level (feet) 80  below  above top of ground.

(4) casing Plastic, 116  
 (material) (depth)  
4 if telescope see back.  
 (size)

(5) screen 14, 116  
 (length) (depth to top)  
008, Plastic  
 (size) (material)


(6) pump \_\_\_\_\_ (HP) \_\_\_\_\_ (yield gpm)  
Wind  
 (type power)

(7) electric log No  
 (yes or no)

\_\_\_\_\_  
 (organization running log)

(8) how well bottom plugged solid


description of formations encountered	from to	
	feet	feet
<i>top soil</i>	<i>0</i>	<i>15</i>
<i>W. clay</i>	<i>15</i>	<i>35</i>
<i>W. clay &amp; sand</i>	<i>35</i>	<i>110</i>
<i>Coarse sand</i>	<i>110</i>	<i>130</i>

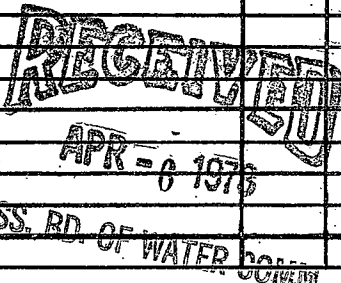

DRILLERS REMARKS:

If well telescopes please sketch and show depths.

GROUND LEVEL

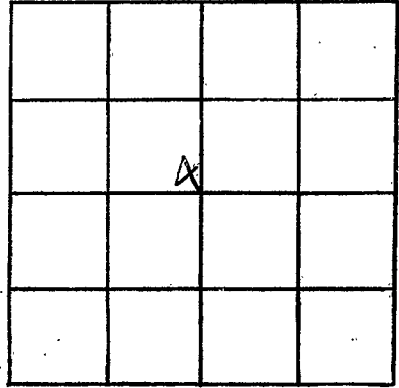

SECTION 35

Please indicate well location X.

ADDITIONAL INFORMATION

If more than one screen, show locations of each on sketch.