

Tate  
 B 2035  
 11/10/77

MISSISSIPPI  
 BOARD OF WATER COMMISSIONERS  
 416 North State Street  
 Jackson, Mississippi 39201

WATER WELL DRILLERS LOG

11/10 1977 date well completed      Hick Well Co firm name      Tate county well located

LANDOWNER: James Billingsley  
 Rt. 2  
 Coldwater Ms.  
 (mailing address)

description of formations encountered	from	to
Red clay	0	10
white clay + sand	10	80
white sand	80	110

WELL LOCATION:  
 sec 23 T 5 N R 7 E W  
 3 miles NE of New York  
 (distance) (direction) (nearest town)

WELL PURPOSE: Home  
 (home, irrigation, municipal, industrial)

WELL COMPLETION DATA:

(1) diameter (inches) 4

(2) total depth (feet) 110

(3) static water level (feet) 40 below top of ground.

(4) casing PVC, 110, (material) (depth)  
 (size) If telescope see back.

(5) screen 7', 103 (length) (depth to top)  
 4" ground type (size) (material)

(6) pump 42, 10 (HP) (yield gpm)  
 220V (type power)

(7) electric log No (yes or no)  
 (organization running log)

(8) how well bottom plugged Cap

RECEIVED


NOV 22 1977

DRILLERS REMARKS:

MISS. BD. OF WATER COMM

If well telescopes please sketch and show depths.

GROUND LEVEL

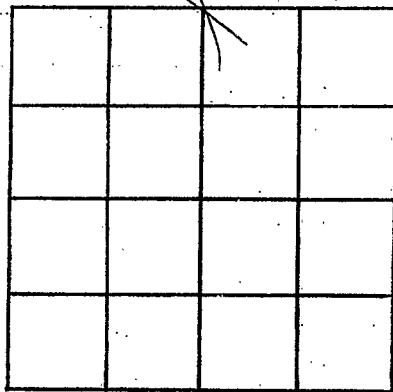

SECTION 23

Please indicate well location X.

ADDITIONAL INFORMATION

Lined area for additional information.

If more than one screen, show locations of each on sketch.