

IATE
Lb 2030
3/20/78
3-20
date well completed 1978

V to see
if you want
to change
I put in
like it reads
Hole depth 180

SIONERS
101
LOG
1.

Fate
county well located

LANDOWNER: <u>Robert Kuehler</u>	description of formations encountered	from	to
<u>Rt. 4</u>	<u>top soil</u>	<u>0</u>	<u>15</u>
<u>Coldwater</u> (mailing address)	<u>sand + gravel</u>	<u>15</u>	<u>45</u>
WELL LOCATION: sec <u>2</u> T <u>5</u> N R <u>7</u> E <u>2 1/2</u> miles <u>W</u> of <u>Proaville</u> (distance) (direction) (nearest town)	<u>W. clay</u>	<u>45</u>	<u>70</u>
WELL PURPOSE: <u>irrigation</u> (home, irrigation, municipal, industrial)	<u>clay + sand</u>	<u>70</u>	<u>160</u>
WELL COMPLETION DATA: (1) diameter (inches) <u>4</u> (2) total depth (feet) <u>180</u> (3) static water level (feet) <u>100</u> <u>below</u> <u>above</u> top of ground. (4) casing <u>Plaster</u> , <u>166</u> (material) (depth) <u>4</u> (size) If telescope see back. (5) screen <u>14</u> , <u>166</u> (length) (depth to top) <u>008</u> , <u>Plastic</u> (size) (material) (6) pump <u>3/4</u> , <u>10</u> (HP) (yield gpm) <u>elec.</u> (type power) (7) electric log <u>N</u> (yes or no) <u>(organization running log)</u> (8) how well bottom plugged <u>solid</u>			
DRILLERS REMARKS:			


RECEIVED

APR - 6 1978

MISS. BD. OF WATER CONTROL

If well telescopes please sketch and show depths.

GROUND LEVEL

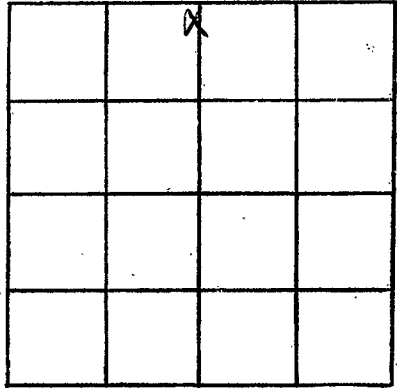

SECTION 2

Please indicate well location X.

ADDITIONAL INFORMATION

If more than one screen, show locations of each on sketch.